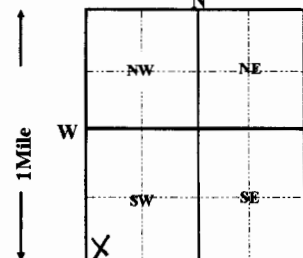


1 LOCATION OF WATER WELL:		FRACTION		Section Number		Township Number		Range Number	
Harvey		SW 1/4 SW 1/4 SW 1/4		23		T 23 S		R 2W E/W	
Distance and direction from nearest town or city street address of well if located within city?									
1/8 E. of Halstead Road, N. side of Hwy 50 Halstead, Kansas									
2 WATER WELL OWNER:		SUTER, J.D.							
RR#, ST. ADDRESS, BOX #:		1641 Jeanette							
CITY, STATE, ZIP CODE:		Wichita, Kansas 67214							
3 LOCATE WELL'S LOCATION WITH AN "X" IN SECTION BOX:		4 DEPTH OF COMPLETED WELL 95 ft. ELEVATION:							
		Depth(s) groundwater Encountered 1 ft. 2 ft. 3 ft.							
		WELL'S STATIC WATER LEVEL 35 FT. BELOW LAND SURFACE MEASURED ON mo/day/yr 09/04/1992							
		Pump test data: Well water was ft. after hours pumping gpm							
		Est. Yield gpm: Well water was ft. after hours pumping gpm							
		Bore Hole Diameter 12 in. to 95 ft., and in. to ft.							
		WELL WATER TO BE USED AS: 5 Public water supply 8 Air conditioning 11 Injection well							
		1 Domestic 3 Feedlot 6 Oil field water supply 9 Dewatering 12 Other (Specify below)							
		2 Irrigation 4 Industrial 7 Lawn and garden only 10 Monitoring well							
		Was a chemical/bacteriological sample submitted to Department? Yes No X ; If yes, mo/day/yr sample was submitted							
5 TYPE OF CASING USED:		CASING JOINTS: Glued X Clamped							
1 Steel 3 RMP (SR)		5 Wrought iron 8 Concrete tile							
2 PVC 4 ABS		6 Asbestos-Cement 9 Other (Specify below)							
		7 Fiberglass SDR-26							
Blank casing Diameter 5 in. to 90 ft., Dia in. to ft., Dia in. to ft.									
Casing height above land surface 12 in., weight 2.35 lbs. / ft.		Wall thickness or gauge No. .214							
TYPE OF SCREEN OR PERFORATION MATERIAL:		7 PVC 10 Asbestos-cement							
1 Steel 3 Stainless Steel		8 RMP (SR) 11 other (specify)							
2 Brass 4 Galvanized steel		9 ABS 12 None used (open hole)							
SCREEN OR PERFORATION OPENING ARE:		5 Gauzed wrapped 8 Saw cut 11 None (open hole)							
1 Continous slot 3 Mill slot		6 Wire wrapped 9 Drilled holes							
2 Louvered shutter 4 Key punched		7 Torch cut 10 Other (specify)							
SCREEN-PERFORATION INTERVALS: from 50 ft. to 70 ft., From ft. to ft.									
		from 90 ft. to 95 ft., From ft. to ft.							
GRAVEL PACK INTERVALS: from 24 ft. to 95 ft., From ft. to ft.									
		from ft. to ft., From ft. to ft.							
6 GROUT MATERIAL: 1 Neat cement 2 Cement grout 3 Bentonite 4 Other									
Grout Intervals: From 4 ft. to 24 ft., From ft. to ft., From ft. to ft.									
What is the nearest source of possible contamination:		10 Livestock pens 14 Abandon water well							
1 Septic tank 4 Lateral lines 7 Pit privy		11 Fuel storage 15 Oil well/Gas well							
2 Sewer lines 5 Cess pool 8 Sewage lagoon		12 Fertilizer storage 16 Other (specify below)							
3 Watertight sewer lines 6 Seepage pit 9 Feedyard									
Direction form well? South		How many feet? 65							
FROM	TO	LITHOLOGIC LOG	FROM	TO	PLUGGING INTERVALS				
0	3	topsoil							
3	43	clay							
43	50	fine sand							
50	65	medium sand							
65	90	brown clay							
90	95	grey shale							
7 CONTRACTOR'S OR LANDOWNER'S CERTIFICATION: This water well was (1) constructed, (2) reconstructed, or (3) plugged under my jurisdiction and was completed on (mo/day/year) 09/04/1992 and this record is true to the best of my knowledge and belief. Kansas Water Well Contractor's License No. 236 This Water Well Record was completed on (mo/day/yr) 11/06/92 Under the business name of Harp Well & Pump Service, Inc. by (signature) Jane Grederrick									