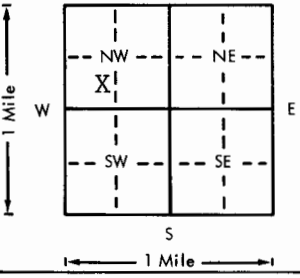


USE TYPEWRITER OR BALL
POINT PEN-PRESS FIRMLY,
PRINT CLEARLY.

WATER WELL RECORD
KSA 82a-1201-1215

Kansas Department of Health and
Environment-Division of Environment
(Water well Contractors)
Topeka, Kansas 66620

1. Location of well:		County Harvey	Fraction S 1/4 NW 1/4	Section number 28	Township number T 23 S	Range number R 2W E 1W
2. Distance and direction from nearest town or city: Street address of well location if in city:			3. Owner of well: R.R. or street: City, state, zip code:			
3 West of Halstead on Highway 50 and			Marvin Westerman R #2 Halstead, Kansas			
4. Locate with "X" in section below:			Sketch map:			6. Bore hole dia. <u>11</u> in. Completion date <u>9-26-77</u> Well depth <u>75</u> ft.
			1/8 mile south on the east side of the road. Halstead, Kansas			7. <u>X</u> Cable tool <u>X</u> Rotary <u> </u> Driven <u> </u> Dug <u> </u> Hollow rod <u> </u> Jetted <u> </u> Bored <u> </u> Reverse rotary
5. Type and color of material			From	To	8. Use: <u> </u> Domestic <u> </u> Public supply <u> </u> Industry <u> </u> Irrigation <u> </u> Air conditioning <u> </u> Stock <u>X</u> Lawn <u> </u> Oil field water <u> </u> Other	
Topsoil			0	3	9. Casing: Material <u>styrene</u> Height: Above or below Threaded <u> </u> Welded <u> </u> Surface <u>12</u> in. RMP <u>X</u> PVC <u> </u> Weight <u> </u> lbs./ft. Dia. <u>5</u> in. to <u>75</u> ft. depth Wall Thickness: inches or Dia. <u> </u> in. to <u> </u> ft. depth gage No. <u>200</u>	
Clay			3	10	10. Screen: Manufacturer's name Sunflower Plastic Type <u>styrene</u> Dia. <u>5</u> " Slot/gauze <u>.06</u> Length <u>15</u> " Set between <u>60</u> ft. and <u>75</u> ft. <u> </u> ft. and <u> </u> ft. Gravel pack? <u>yes</u> Size range of material <u>1/4-1/8"</u>	
Fine Sand			10	30	11. Static water level: <u> </u> mo./day/yr. <u>40</u> ft. below land surface Date <u>9-26-77</u>	
Clay			30	58	12. Pumping level below land surfaces: <u> </u> ft. after <u> </u> hrs. pumping <u> </u> g.p.m. <u> </u> ft. after <u> </u> hrs. pumping <u> </u> g.p.m. Estimated maximum yield <u> </u> g.p.m.	
Fine Sand			58	75	13. Water sample submitted: <u> </u> mo./day/yr. <u> </u> Yes <u> </u> No Date <u> </u>	
					14. Well head completion: <u>12</u> capped <u> </u> Pitless adapter <u> </u> Inches above grade	
					15. Well grouted? <u>yes</u> <u>1-2</u> fine sand mix With: <u> </u> Neat cement <u> </u> Bentonite <u>X</u> Concrete Depth: From <u>40</u> " ft. to <u>14</u> ft.	
					16. Nearest source of possible contamination: ft. <u>150</u> Direction <u>SE</u> Type <u>Pond</u> Well disinfected upon completion? <u>X</u> Yes <u> </u> No	
					17. Pump: <u>X</u> Not installed Manufacturer's name <u> </u> Model number <u> </u> HP <u> </u> Volts <u> </u> Length of drop pipe <u> </u> ft. capacity <u> </u> g.p.m. Type: <u> </u> Submersible <u> </u> Turbine <u> </u> Jet <u> </u> Reciprocating <u> </u> Centrifugal <u> </u> Other	
			(Use a second sheet if needed)			
18. Elevation:		19. Remarks:		20. Water well contractor's certification: This well was drilled under my jurisdiction and this report is true to the best of my knowledge and belief. Harp Well & Pump Serv. 236 Business name <u>Wichita, Kansas</u> <u>67209</u> Address <u> </u> Signed <u>M. Arnold</u> Date <u>10-4-77</u> Authorized representative		
Topography: <u>X</u> Hill <u> </u> Slope <u> </u> Upland <u> </u> Valley						