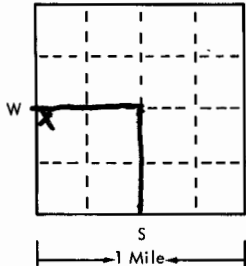
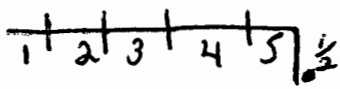


USE TYPEWRITER OR BALL
POINT PEN-PRESS FIRMLY,
PRINT CLEARLY.

WATER WELL RECORD
KSA 82a-1201-1215

23 2 W 29 W W W W W
T R EW sec 1/4 1/4 1/4 No.

Kansas State Dept. Of Health
(Water Well Contractors)
Forbes-Bldg. 740
Topeka, Kansas 66620

1 Location of well:	County Harvey	Township name Halstead	Fraction NW/NE/SE	Section number 29	Town number 23 S	Range number 2 W
Distance and direction from nearest town or city: 5 miles east, 1/2 mile south of Burrton-McPherson Road				3 Owner of well: Blackstone Drilling Co. Address: McPherson, Kansas 67460		
Locate with "X" in section below: 				Sketch map: 		
4 Well depth: 80 ft. Date of completion: 2-17-78 Well diameter: 6 in.				5 <input type="checkbox"/> Cable tool <input checked="" type="checkbox"/> Rotary <input type="checkbox"/> Driven <input type="checkbox"/> Dug <input type="checkbox"/> Hollow rod <input type="checkbox"/> Jetted <input type="checkbox"/> Bored <input type="checkbox"/> Reverse rotary		
6 Use: <input type="checkbox"/> Domestic <input type="checkbox"/> Public supply <input type="checkbox"/> Industry <input type="checkbox"/> Irrigation <input type="checkbox"/> Air conditioning <input type="checkbox"/> Commercial <input type="checkbox"/> Test well <input checked="" type="checkbox"/> oil well water				7 Casing: Material Plastic Height: above/below Threaded <input type="checkbox"/> PVC <input checked="" type="checkbox"/> Welded <input type="checkbox"/> Surface 18 in. Diam. 60 lbs. Weight 216 3 in. to 60 ft. depth Drive shoe? <input type="checkbox"/> Yes <input checked="" type="checkbox"/> No 3 in. to 60 ft. depth		
2 Type and color of material				From	To	8 Screen: Manufacturer Certain-tecd Type Sawed Dia. 3 Slot/gauze 1/8 Length 20 Set between 50 ft. and 90 ft. Fittings: Gravel pack <input checked="" type="checkbox"/> Yes <input type="checkbox"/> No Size range of material 1/8 x 1/4
Top Soil				0	5	9 Static water level: 32 ft. below land surface Date 2-17-78
Clay				5	45	10 Pumping level below land surfaces: 35 ft. after 1 hrs. pumping 20 g.p.m. ____ ft. after ____ hrs. pumping ____ g.p.m. Estimated maximum yield 50 g.p.m.
Sand				45	77	11 Water sample submitted: <input type="checkbox"/> Yes <input checked="" type="checkbox"/> No Date ____
Shale				77	80	12 Well head completion: <input type="checkbox"/> Pitless adapter 18 Inches above grade
						13 Well grouted? <input checked="" type="checkbox"/> Yes <input type="checkbox"/> No <input type="checkbox"/> Neat cement <input checked="" type="checkbox"/> Bentonite <input type="checkbox"/> Depth: From 0 ft. to 10 ft.
						14 Nearest source of possible contamination: ft. ____ Direction none Type ____ Well disinfected upon completion? <input type="checkbox"/> Yes <input checked="" type="checkbox"/> No
						15 Pump: <input checked="" type="checkbox"/> Not installed Manufacturer's name ____ Model number ____ HP ____ Volts ____ Length of drop pipe ____ ft. capacity ____ g.m.p. Type: <input type="checkbox"/> Submersible <input type="checkbox"/> Turbine <input type="checkbox"/> Jet <input type="checkbox"/> Reciprocating <input type="checkbox"/> Centrifugal <input type="checkbox"/> Other
(use a second sheet if needed)						
16 Remarks: elevation Topography: <input type="checkbox"/> Hill <input checked="" type="checkbox"/> Slope <input type="checkbox"/> Upland <input type="checkbox"/> Valley				17 Water well contractor's certification: This well was drilled under my jurisdiction and this report is true to the best of my knowledge and belief. Darling Drilling Co. 189 Business name License No. Address 121 W. 4th, Hutchinson, Kans. Signed Donald Darling 6-4-79 Authorized representative		