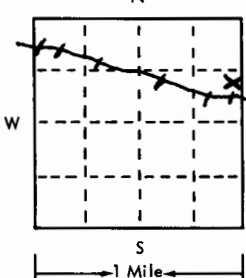
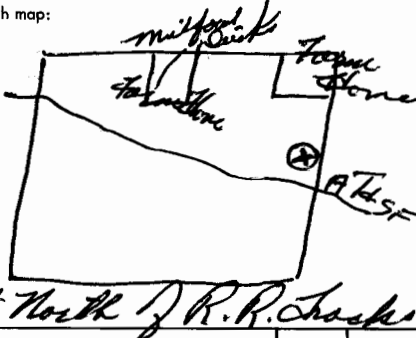


USE TYPEWRITER OR BALL
POINT PEN-PRESS FIRMLY,
PRINT CLEARLY.

WATER WELL RECORD
KSA 82a-1201-1215

T R EW sec 1/4 1/4 1/4 No.

Kansas State Dept. Of Health
(Water Well Contractors)
Forbes-Bldg. 740
Topeka, Kansas 66620

1 Location of well:	County	Township name	Fraction	Section number	Town number	Range number
NW Corner of SE 1/4 of NE 1/4						
Harvey Halstead 32 T-23-S R-2-W						
Distance and direction from nearest town or city: 2 West - 1/2 mi. of Halstead				3 Owner of well: Milford Oliver		
Street address of well location if in city: on County Road - 3/4 mile North - West of R.R. 1.				Address: Halstead, Kans.		
Locate with "X" in section below:		Sketch map:		4 Well depth: 207 ft. Date of completion 6-9-75		
				Well diameter 28" in.		
2		Type and color of material		From		To
		Top Soil		0		7
		Silty Clay		7		14
		Med sand & gravel loose		14		23
		Red - Blue & Grey Clay Layer		23		59
		Med sand & gravel - loose		59		72
		Pink Clay		72		86
		Med sand & gravel - loose		86		92
		Pink Clay		92		123
		Light Blue Clay		123		126
		White Clay		126		140
		Very fine sand		140		150
		Med Equis sand		150		178
		Buff Clay		178		183
		Med Equis sand		183		207
		Green & Blue shale		207		209
		(use a second sheet if needed)				
16 Remarks: elevation						
This section of farm land flat						
Topography: <input type="checkbox"/> Hill <input type="checkbox"/> Slope <input checked="" type="checkbox"/> Upland <input type="checkbox"/> Valley						
17 Water well contractor's certification: This well was drilled under my jurisdiction and this report is true to the best of my knowledge and belief. Peterson Bros Inc 138 Business name License No. Address Box 150 Lindsay, KS Signed Wallace Peterson Date 6-9-75 Authorized representative						