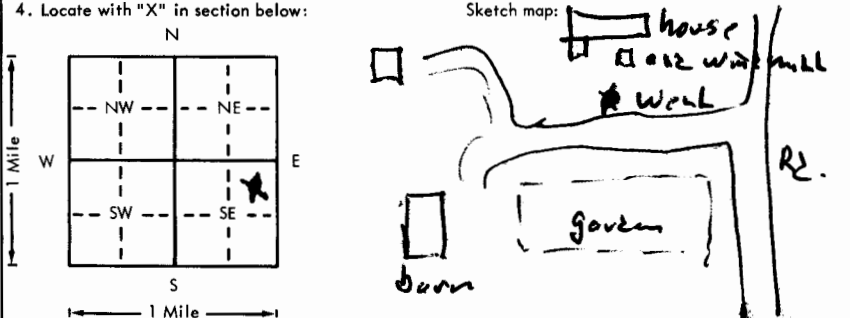


USE TYPEWRITER OR BALL
POINT PEN-PRESS FIRMLY,
PRINT CLEARLY.

WATER WELL RECORD
KSA 82a-1201-1215

Kansas Department of Health and
Environment-Division of Environment
(Water well Contractors)
Topeka, Kansas 66620

1. Location of well:	County HARVEY	Fraction NE 1/4 NE 1/4 SE 1/4	Section number 33	Township number T 23	Range number S R 2
2. Distance and direction from nearest town or city: Street address of well location if in city:	1 mile West of Holstead		3. Owner of well: EVERETT MC WILLIAMS R.R. or street: RR #2 Box 18 City, state, zip code: HALSTED KNS 60756		
4. Locate with "X" in section below:	Sketch map:		6. Bore hole dia. 11 in. Completion date 4/16/79 Well depth 78 ft.		
			7. <input checked="" type="checkbox"/> Cable tool <input checked="" type="checkbox"/> Rotary <input type="checkbox"/> Driven <input type="checkbox"/> Dug <input type="checkbox"/> Hollow rod <input type="checkbox"/> Jetted <input type="checkbox"/> Bored <input type="checkbox"/> Reverse rotary		
			8. Use: <input type="checkbox"/> Domestic <input type="checkbox"/> Public supply <input type="checkbox"/> Industry <input type="checkbox"/> Irrigation <input type="checkbox"/> Air conditioning <input checked="" type="checkbox"/> Stock <input type="checkbox"/> Lawn <input type="checkbox"/> Oil field water <input type="checkbox"/> Other		
5. Type and color of material	From		To		9. Casing: Material Plastic Height Above or below Threaded <input type="checkbox"/> Welded <input checked="" type="checkbox"/> Surface 12 in. RMP <input type="checkbox"/> PVC <input checked="" type="checkbox"/> Weight 2.82 lbs./ft. Dia. 5 in. to 28 ft. depth Wall Thickness: inches or Dia. <input type="checkbox"/> in. to <input type="checkbox"/> ft. depth gage No. 1258
top soil	0		2		10. Screen: Manufacturer's name Pumpco Type PVC Dia. 5" Slot/gauze 1020 Length 14 Set between 18 ft. and 22 ft. 68 ft. and 78 ft. Gravel pack? <input checked="" type="checkbox"/> Size range of material 1/4-1/4"
brown clay w/ SAND	2		8		11. Static water level: <input type="checkbox"/> mo./day/yr. 16 ft. below land surface Date 4/16/79
fine SAND - rust color	8		15		12. Pumping level below land surfaces: ft. after <input type="checkbox"/> hrs. pumping <input type="checkbox"/> g.p.m. 66 ft. after 3 hrs. pumping 12 g.p.m. Estimated maximum yield <input type="checkbox"/> g.p.m.
coarse SAND	15		22		13. Water sample submitted: <input type="checkbox"/> Yes <input checked="" type="checkbox"/> No Date <input type="checkbox"/>
blue gray clay (embittered fossils)	22		51		14. Well head completion: <input checked="" type="checkbox"/> Pitless adapter 12 inches above grade
med to coarse SAND	51		59		15. Well grouted? <input checked="" type="checkbox"/> With: <input checked="" type="checkbox"/> Neat cement <input type="checkbox"/> Bentonite <input type="checkbox"/> Concrete Depth: From 0 ft. to 12 ft.
marbled gray/black clay	59		69		16. Nearest source of possible contamination: ft. 100 Direction NE Type Septic field Well disinfected upon completion? <input checked="" type="checkbox"/> Yes <input type="checkbox"/> No
med to coarse SAND	69		77		17. Pump: <input type="checkbox"/> Not installed Manufacturer's name Dempster Model number M23-50 Volts 230 Length of drop pipe 73 ft. capacity 12 g.p.m. Type: <input checked="" type="checkbox"/> Submersible <input type="checkbox"/> Turbine <input type="checkbox"/> Jet <input type="checkbox"/> Reciprocating <input type="checkbox"/> Centrifugal <input type="checkbox"/> Other
dark clay	77		78		20. Water well contractor's certification: This well was drilled under my jurisdiction and this report is true to the best of my knowledge and belief. PAUL'S INC #125 Business name Box 26 NESSPA KS License No. Address Paul Burkert Date 4/22/79 Signed Paul Burkert Authorized representative
18. Elevation:	19. Remarks: Cemented & capped old existing driven well.				
Topography: <input type="checkbox"/> Hill <input type="checkbox"/> Slope <input type="checkbox"/> Upland <input type="checkbox"/> Valley					