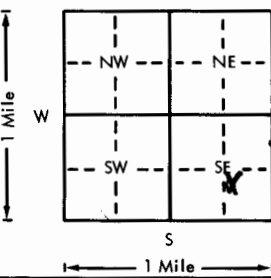
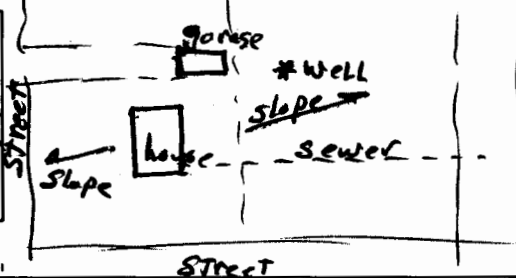


USE TYPEWRITER OR BALL  
POINT PEN-PRESS FIRMLY,  
PRINT CLEARLY.

WATER WELL RECORD  
KSA 82a-1201-1215

Kansas Department of Health and  
Environment-Division of Environment  
(Water well Contractors)  
Topeka, Kansas 66620

1. Location of well:	County <b>HARVEY</b>	Fraction <b>NW 1/4 SE 1/4 SE 1/4</b>	Section number <b>35</b>	Township number <b>T 23 -</b>	Range number <b>S R 2</b>	<b>EW</b>
2. Distance and direction from nearest town or city: Street address of well location if in city: <b>SAME</b>			3. Owner of well: <b>John Allison</b> R.R. or street: <b>Spruce + 11th St.</b> City, state, zip code: <b>HALSTEAD, KNS</b>			
4. Locate with "X" in section below:		Sketch map:		6. Bore hole dia. <b>10</b> in. Completion date <b>6-16-77</b> Well depth <b>48</b> ft.		
				7. <input checked="" type="checkbox"/> Cable tool <input checked="" type="checkbox"/> Rotary <input type="checkbox"/> Driven <input type="checkbox"/> Dug <input type="checkbox"/> Hollow rod <input type="checkbox"/> Jetted <input type="checkbox"/> Bored <input type="checkbox"/> Reverse rotary		
5. Type and color of material		From	To	8. Use: <input type="checkbox"/> Domestic <input type="checkbox"/> Public supply <input type="checkbox"/> Industry <input checked="" type="checkbox"/> Irrigation <input type="checkbox"/> Air conditioning <input type="checkbox"/> Stock <input checked="" type="checkbox"/> Lawn <input type="checkbox"/> Oil field water <input type="checkbox"/> Other		
Loam		1	5	9. Casing: Material <b>plastic</b> Height <b>Above</b> or below Threaded <input type="checkbox"/> Welded <input type="checkbox"/> Surface <b>34</b> in. RMP <input type="checkbox"/> PVC <input checked="" type="checkbox"/> Weight <b>2.28</b> lbs./ft. Dia. <b>1.5</b> in. to <b>4.0</b> ft. depth Wall Thickness: inches or Dia. <input type="checkbox"/> in. to <input type="checkbox"/> ft. depth gage No. <b>2.28</b>		
Light br clay to dark br clay		5	10	10. Screen: Manufacturer's name <b>Kam-Tech - own slot</b> Type <b>5" PVC</b> Dia. <b>5"</b> Slot/gauze <b>.046</b> Length <b>20'</b> Set between <b>28</b> ft. and <b>48</b> ft. Gravel pack? <input checked="" type="checkbox"/> Size range of material <b>1/8-1/4</b>		
Dark br clay		10	15	11. Static water level: <b>19</b> ft. below land surface Date <b>6-16-77</b> mo./day/yr.		
" " " (same sand fine)		15	20	12. Pumping level below land surfaces: <b>19</b> ft. after <b>1</b> hrs. pumping <b>20</b> g.p.m. ft. after <input type="checkbox"/> hrs. pumping <input type="checkbox"/> g.p.m. Estimated maximum yield <b>80-100</b> g.p.m.		
" " "		20	25	13. Water sample submitted: <input type="checkbox"/> Yes <input checked="" type="checkbox"/> No Date <input type="checkbox"/>		
heavy black-gray clay		25	27	14. Well head completion: <b>24</b> inches above grade Pitless adapter <input type="checkbox"/>		
med sand		27	30	15. Well grouted? <b>No</b> With: <input type="checkbox"/> Neat cement <input type="checkbox"/> Bentonite <input type="checkbox"/> Concrete Depth: From <input type="checkbox"/> ft. to <input type="checkbox"/> ft.		
med to fine sand		30	35	16. Nearest source of possible contamination: ft. <b>42</b> Direction <b>South</b> Type <b>Sewer</b> Well disinfected upon completion? <input type="checkbox"/> Yes <input type="checkbox"/> No		
fine to coarse "		35	40	17. Pump: <input checked="" type="checkbox"/> Not installed Manufacturer's name <input type="checkbox"/> Model number <input type="checkbox"/> HP <input type="checkbox"/> Volts <input type="checkbox"/> Length of drop pipe <input type="checkbox"/> ft. capacity <input type="checkbox"/> g.p.m. Type: <input type="checkbox"/> Submersible <input type="checkbox"/> Turbine <input type="checkbox"/> Jet <input type="checkbox"/> Reciprocating <input type="checkbox"/> Centrifugal <input type="checkbox"/> Other		
coarse sand		40	44			
black to reddish clay		44	48			
(Use a second sheet if needed)						
18. Elevation:	19. Remarks: <b>Owner To grout</b>		20. Water well contractor's certification: This well was drilled under my jurisdiction and this report is true to the best of my knowledge and belief. <b>PAULS INC</b> #125 Business name License No. Address <b>HEGSTON, KNS</b> Signed <b>Paul Bullert</b> Date <b>6-16-77</b> Authorized representative			
Topography: <input type="checkbox"/> Hill <input type="checkbox"/> Slope <input type="checkbox"/> Upland <input type="checkbox"/> Valley						