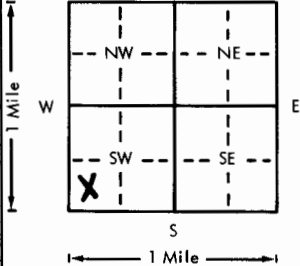


USE TYPEWRITER OR BALL
POINT PEN-PRESS FIRMLY,
PRINT CLEARLY.

WATER WELL RECORD
KSA 82a-1201-1215

Kansas Department of Health and
Environment-Division of Environment
(Water well Contractors)
Topeka, Kansas 66620

1. Location of well:	County Harvey	Fraction 1/4 SW 1/4 SW 1/4	Section number 35	Township number T 23 S R 2W E/W	Range number
2. Distance and direction from nearest town or city: Street address of well location if in city: 528 West St. Halstead, KS			3. Owner of well: Ardel Koehn R.R. or street: 528 West St. City, state, zip code: Halstead, KS		
4. Locate with "X" in section below: Sketch map: 			6. Bore hole dia. 11 in. Completion date 10-28-78 Well depth 50 ft.		
5. Type and color of material			7. <input type="checkbox"/> Cable tool <input checked="" type="checkbox"/> Rotary <input type="checkbox"/> Driven <input type="checkbox"/> Dug <input type="checkbox"/> Hollow rod <input type="checkbox"/> Jetted <input type="checkbox"/> Bored <input type="checkbox"/> Reverse rotary		
			8. Use: <input type="checkbox"/> Domestic <input type="checkbox"/> Public supply <input type="checkbox"/> Industry <input type="checkbox"/> Irrigation <input type="checkbox"/> Air conditioning <input type="checkbox"/> Stock <input checked="" type="checkbox"/> Lawn <input type="checkbox"/> Oil field water <input type="checkbox"/> Other		
			9. Casing: Material Styrene Height: Above or below 11 Threaded <input type="checkbox"/> Welded <input checked="" type="checkbox"/> Surface 12 in. RMP <input checked="" type="checkbox"/> PVC <input type="checkbox"/> Weight 12 lbs./ft. Dia. 5 in. to 50 ft. depth Wall Thickness: inches or Dia. 5 in. to 50 ft. depth gage No. 200		
			10. Screen: Manufacturer's name Sunflower plastic Type Styrene Dia. 5" Slot/gauze .06 Length 20' Set between 30 ft. and 50 ft. Gravel pack? yes Size range of material 1-1/8"		
			From	To	11. Static water level: 25 ft. below land surface Date 10-28-78
Topsoil			0	3	12. Pumping level below land surfaces: ____ ft. after ____ hrs. pumping ____ g.p.m. ____ ft. after ____ hrs. pumping ____ g.p.m. Estimated maximum yield ____ g.p.m.
Clay			3	24	13. Water sample submitted: ____ mo./day/yr. ____ Yes ____ No Date ____
Fine to Medium Sand			24	50	14. Well head completion: <input checked="" type="checkbox"/> Pitless adapter 12 inches above grade
					15. Well grouted? yes 1-2 fine sand mix With: ____ Neat cement ____ Bentonite <input checked="" type="checkbox"/> Concrete Depth: From 40" ft. to 14 ft.
					16. Nearest source of possible contamination: ft. 55 Direction Southeast Type City Sewer Well disinfected upon completion? <input checked="" type="checkbox"/> Yes ____ No
					17. Pump: ____ Not installed Manufacturer's name Jacuzzi Model number 7S4C HP 3/4 Volts 230 Length of drop pipe 40 ft. capacity 18 g.p.m. Type: <input checked="" type="checkbox"/> Submersible ____ Turbine ____ Jet ____ Reciprocating ____ Centrifugal ____ Other
(Use a second sheet if needed)					20. Water well contractor's certification: This well was drilled under my jurisdiction and this report is true to the best of my knowledge and belief. Harp Well & Pump 236 Business name License No. Address Wichita, Kansas 67209 Signed M. Orselle Date 6-19-79 Authorized representative
18. Elevation: Flat Ground Topography: ____ Hill ____ Slope ____ Upland ____ Valley	19. Remarks:				