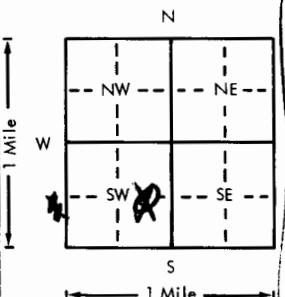
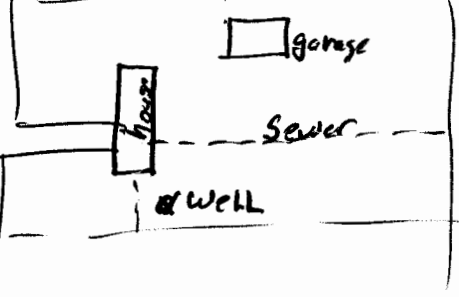


USE TYPEWRITER OR BALL  
POINT PEN-PRESS FIRMLY,  
PRINT CLEARLY.

WATER WELL RECORD  
KSA 82a-1201-1215

Kansas Department of Health and  
Environment-Division of Environment  
(Water well Contractors)  
Topeka, Kansas 66620

1. Location of well:		County <b>HARVEY</b>	Fraction <b>NE 1/4 SW 1/4</b>	Section number <b>35</b>	Township number <b>T 23 S</b>	Range number <b>R 2 E</b>
2. Distance and direction from nearest town or city: Street address of well location if in city:			3. Owner of well: R.R. or street: City, state, zip code:			
<b>SAME</b>			<b>HARRY Krueger</b> <b>412 SW 2nd ST</b> <b>HAUSTEAD, KANSAS</b>			
4. Locate with "X" in section below:		Sketch map:		6. Bore hole dia. <b>11"</b> in. Completion date <b>10/14/78</b> Well depth <b>48</b> ft.		
				7. <input checked="" type="checkbox"/> Cable tool <input checked="" type="checkbox"/> Rotary <input type="checkbox"/> Driven <input type="checkbox"/> Dug <input type="checkbox"/> Hollow rod <input type="checkbox"/> Jetted <input type="checkbox"/> Bored <input type="checkbox"/> Reverse rotary		
5. Type and color of material				From	To	8. Use: <input type="checkbox"/> Domestic <input type="checkbox"/> Public supply <input type="checkbox"/> Industry <input checked="" type="checkbox"/> Irrigation <input type="checkbox"/> Air conditioning <input type="checkbox"/> Stock <input checked="" type="checkbox"/> Lawn <input type="checkbox"/> Oil field water <input type="checkbox"/> Other
<b>LOAM</b>				<b>0</b>	<b>5</b>	9. Casing: Material <b>PLASTIC</b> Height: Above or below Threaded <input type="checkbox"/> Welded <input checked="" type="checkbox"/> Surface <b>18</b> in. RMP <input type="checkbox"/> PVC <input checked="" type="checkbox"/> Weight <b>2.87</b> lbs./ft. Dia. <b>5</b> in. to <b>48</b> ft. depth Wall Thickness: inches or Dia. <input type="checkbox"/> in. to <input type="checkbox"/> ft. depth gage No. <b>1258</b>
<b>RED-BROWN CLAY</b>				<b>5</b>	<b>10</b>	10. Screen: Manufacturer's name <b>Kam-Tech</b> Type <b>PVC</b> Dia. <b>5"</b> Slot/gauze <b>1020</b> Length <b>10'</b> Set between <b>35</b> ft. and <b>45</b> ft. Gravel pack? <input checked="" type="checkbox"/> Size range of material <b>1/8-1/4</b>
<b>BROWN CLAY</b>				<b>10</b>	<b>15</b>	11. Static water level: <b>21</b> ft. below land surface Date <b>10-6-78</b>
<b>GREY BROWN CLAY</b>				<b>15</b>	<b>20</b>	12. Pumping level below land surfaces: <b>23</b> ft. after <b>2</b> hrs. pumping <b>18</b> g.p.m. Estimated maximum yield <b>50/60</b> g.p.m.
<b>" " CLAY to MED coarse SD.</b>				<b>20</b>	<b>25</b>	13. Water sample submitted: <b>10-6-78</b> <input type="checkbox"/> Yes <input checked="" type="checkbox"/> No Date
<b>MED FINE SAND</b>				<b>25</b>	<b>35</b>	14. Well head completion: <input type="checkbox"/> Pitless adapter <b>18</b> Inches above grade
<b>COMPACTED BQUS SAND-MED</b>				<b>35</b>	<b>46</b>	15. Well grouted? <input checked="" type="checkbox"/> With: <input checked="" type="checkbox"/> Neat cement <input type="checkbox"/> Bentonite <input type="checkbox"/> Concrete Depth: From <b>10</b> ft. to <b>0</b> ft.
<b>Blue-GREY CLAY LEDGE</b>				<b>46</b>	<b>48</b>	16. Nearest source of possible contamination: <b>house</b> ft. <b>12</b> Direction <b>North</b> Type <b>sewer</b> Well disinfected upon completion? <input type="checkbox"/> Yes <input checked="" type="checkbox"/> No
						17. Pump: <input type="checkbox"/> Not installed Manufacturer's name <b>Dempster</b> Model number <b>HL-50-3HP3</b> 1/2 Volts <b>115</b> Length of drop pipe <b>40</b> ft. capacity <b>18</b> g.p.m. Type: <input checked="" type="checkbox"/> Submersible <input type="checkbox"/> Turbine <input type="checkbox"/> Jet <input type="checkbox"/> Reciprocating <input type="checkbox"/> Centrifugal <input type="checkbox"/> Other
						18. Elevation:
						19. Remarks:
						20. Water well contractor's certification: This well was drilled under my jurisdiction and this report is true to the best of my knowledge and belief. <b>PAUL'S INC</b> #175 Business name License No. Address <b>HESTON, KANSAS</b> Signed <b>Paul Bumbart</b> Date <b>10/14/78</b> Authorized representative