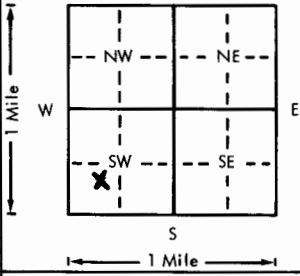


USE TYPEWRITER OR BALL
POINT PEN-PRESS FIRMLY,
PRINT CLEARLY.

WATER WELL RECORD
KSA 82a-1201-1215

Kansas Department of Health and
Environment-Division of Environment
(Water well Contractors)
Topeka, Kansas 66620

1. Location of well:		County Harvey	Fraction 1/4 SW 1/4 SW 1/4	Section number 35	Township number T 23	Range number R 2 W E/W
2. Distance and direction from nearest town or city: Street address of well location if in city: 728 West 4th Halstead, KS				3. Owner of well: Danny Benbrook R.R. or street: 728 West 4th City, state, zip code: Halstead, KS		
4. Locate with "X" in section below: Sketch map: 				6. Bore hole dia. 11 in. Completion date 11-4-78 Well depth 50 ft.		
5. Type and color of material				7. <input type="checkbox"/> Cable tool <input checked="" type="checkbox"/> Rotary <input type="checkbox"/> Driven <input type="checkbox"/> Dug <input type="checkbox"/> Hollow rod <input type="checkbox"/> Jetted <input type="checkbox"/> Bored <input type="checkbox"/> Reverse rotary		
				8. Use: <input type="checkbox"/> Domestic <input type="checkbox"/> Public supply <input type="checkbox"/> Industry <input checked="" type="checkbox"/> Irrigation <input type="checkbox"/> Air conditioning <input type="checkbox"/> Stock <input checked="" type="checkbox"/> Lawn <input type="checkbox"/> Oil field water <input type="checkbox"/> Other		
				9. Casing: Material Styrene Height: Above or below Threaded <input type="checkbox"/> Welded <input checked="" type="checkbox"/> Surface 12 in. RMP <input checked="" type="checkbox"/> PVC <input type="checkbox"/> Weight <input type="checkbox"/> lbs./ft. Dia. 5 in. to 50 ft. depth Wall Thickness: inches or Dia. <input type="checkbox"/> in. to <input type="checkbox"/> ft. depth Gauge No. .200		
				10. Screen: Manufacturer's name Sunflower plastic Type styrene Dia. 5" Slot/dia. .06 Length 15' Set between 35 ft. and 50 ft. ft. and <input type="checkbox"/> ft. Gravel pack? yes Size range of material 1/4-1/8"		
				11. Static water level: <input type="checkbox"/> mo./day/yr. 25 ft. below land surface Date 11-4-78		
(Use a second sheet if needed)				12. Pumping level below land surfaces: ft. after <input type="checkbox"/> hrs. pumping <input type="checkbox"/> g.p.m. ft. after <input type="checkbox"/> hrs. pumping <input type="checkbox"/> g.p.m. Estimated maximum yield <input type="checkbox"/> g.p.m.		
				13. Water sample submitted: <input type="checkbox"/> mo./day/yr. <input type="checkbox"/> Yes <input type="checkbox"/> No Date <input type="checkbox"/>		
				14. Well head completion: 12 well seal <input type="checkbox"/> Pitless adapter <input type="checkbox"/> inches above grade		
				15. Well grouted? yes 1-2 fine sand mix With: <input type="checkbox"/> Neat cement <input type="checkbox"/> Bentonite <input checked="" type="checkbox"/> Concrete Depth: From 40 ft. to 14 ft.		
				16. Nearest source of possible contamination: City ft. 50 Direction North Type Sewer Well disinfected upon completion? <input checked="" type="checkbox"/> Yes <input type="checkbox"/> No		
(Use a second sheet if needed)				17. Pump: Manufacturer's name Jacuzzi Not installed Model number 7S4C HP 3/4 Volts 230 Length of drop pipe 40 ft. capacity 18 g.p.m. Type: <input checked="" type="checkbox"/> Submersible <input type="checkbox"/> Turbine <input type="checkbox"/> Jet <input type="checkbox"/> Reciprocating <input type="checkbox"/> Centrifugal <input type="checkbox"/> Other		
				20. Water well contractor's certification: This well was drilled under my jurisdiction and this report is true to the best of my knowledge and belief. Harp Well & Pump 236 Business name License No. Address Wichita, Kansas 67209 Signed M. Arnold Date 6-19-79 Authorized representative		
				18. Elevation: Flat Ground		
				19. Remarks:		
				Topography: <input type="checkbox"/> Hill <input type="checkbox"/> Slope <input type="checkbox"/> Upland <input type="checkbox"/> Valley		