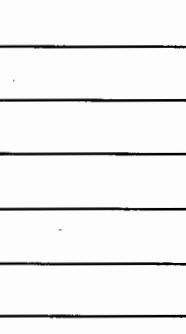


County	Harvey	Fraction	1/4 NW 1/4 SW 1/4	Section number	35	Township number	T 23 S R 2W E/W
1. Location of well:				Frieda Zismann 320 West St. Halstead, KS			
2. Distance and direction from nearest town or city: Street address of well location if in city: Halstead, KS				3. Owner of well: R.R. or street: City, state, zip code:			
4. Locate with "X" in section below: <div style="text-align: center; margin-top: 10px;"></div>				Sketch map:			
5. Type and color of material				6. Bore hole dia. 11 in. Completion date 10-27-78 Well depth 50 ft.			
				7. Cable tool X Rotary Driven Dug Hollow rod Jetted Bored Reverse rotary			
				8. Use: Domestic Public supply Industry Irrigation Air conditioning Stock Lawn Oil field water Other			
				9. Casing: Material Styrene Height: Above or Below Threaded Welded gl Surface 12 in. RMP X PVC Weight lbs./ft. Dia. 5 in. to 50 ft. depth Wall Thickness: inches or Dia. in. to ft. depth Gauge No. .200			
				10. Screen: Manufacturer's name Sunflower plastic Type styrene Dia. 5" Slot/gauge .06 Length 20' Set between 30 ft. and 50 ft. Gravel pack? yes Size range of material 1/4 - 1/8"			
				11. Static water level: mo./day/yr. 25 ft. below land surface Date 10-27-78			
				12. Pumping level below land surfaces: ft. after hrs. pumping g.p.m. ft. after hrs. pumping g.p.m. Estimated maximum yield g.p.m.			
				13. Water sample submitted: mo./day/yr. Yes No Date			
				14. Well head completion: X Pitless adapter 12 Inches above grade			
				15. Well grouted? yes 1-2 fine sand mix With: Neat cement Bentonite X Concrete Depth: From 40" ft. to 14 ft.			
				16. Nearest source of possible contamination: ft. 50 Direction East Type City Se Well disinfected upon completion? X Yes No			
				17. Pump: Manufacturer's name Jacuzzi Not installed Model number 7S4C HP 3/4 Volts 230 Length of drop pipe 40 ft. capacity 18 g.p.m. Type: X Submersible Turbine Jet Reciprocating Centrifugal Other			
18. Elevation: Flat Ground				20. Water well contractor's certification: This well was drilled under my jurisdiction and this report is true to the best of my knowledge and belief. Business name Harp Well & Pump License No. 236 Address Wichita, Kansas 67209 Signature M. Arnold Date 10-30-78 Authorized representative			
Topography: Hill Slope Upland Valley							

(Use a second sheet if needed)