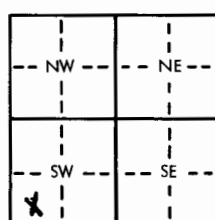
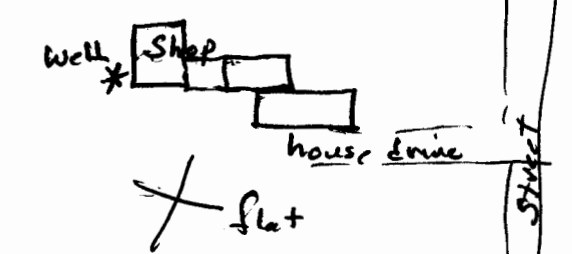


USE TYPEWRITER OR BALL
POINT PEN-PRESS FIRMLY,
PRINT CLEARLY.

WATER WELL RECORD
KSA 82a-1201-1215

Kansas Department of Health and
Environment-Division of Environment
(Water well Contractors)
Topeka, Kansas 66620

1. Location of well: HARVEY		Fraction SW 1/4 SW 1/4 SW 1/4	Section number 35	Township number T 23	Range number S 8 R 2
2. Distance and direction from nearest town or city: Street address of well location if in city: SAME			3. Owner of well: ELMER JANZEN R.R. or street: 505 WEST ST. City, state, zip code: HALSTEAD, KNS		
4. Locate with "X" in section below: 		Sketch map: Sewer 		6. Bore hole dia. 10" in. Completion date 6-27-77 Well depth 48' ft.	
5. Type and color of material		From	To	7. <input checked="" type="checkbox"/> Cable tool <input checked="" type="checkbox"/> Rotary <input type="checkbox"/> Driven <input type="checkbox"/> Dug <input type="checkbox"/> Hollow rod <input type="checkbox"/> Jetted <input type="checkbox"/> Bored <input type="checkbox"/> Reverse rotary	
SANDY Loam		1	5	8. Use: <input checked="" type="checkbox"/> Domestic <input type="checkbox"/> Public supply <input type="checkbox"/> Industry <input checked="" type="checkbox"/> Irrigation <input type="checkbox"/> Air conditioning <input type="checkbox"/> Stock <input checked="" type="checkbox"/> Lawn <input type="checkbox"/> Oil field water <input type="checkbox"/> Other	
Brown clay		5	10	9. Casing: Material plastic Height: Above or below Threaded <input type="checkbox"/> Welded <input checked="" type="checkbox"/> Surface 24 in. RMP <input type="checkbox"/> PVC <input checked="" type="checkbox"/> Weight 2.28 lbs./ft. Dia. 5 in. to 48 ft. depth Wall Thickness: inches or Dia. <input type="checkbox"/> in. to <input type="checkbox"/> ft. depth Gage No. 1255	
" "		10	15	10. Screen: Manufacturer's name Kem-Tech - Owen Slot Type PVC Dia. 5" Slot/gauze 1046 Length 20' Set between 28 ft. and 48 ft. ft. and <input type="checkbox"/> ft. Gravel pack? <input checked="" type="checkbox"/> Size range of material 48-44	
Brown clay to dark br clay		15	20	11. Static water level: <input type="checkbox"/> mo./day/yr. 19' ft. below land surface Date 6-16-77	
br grey clay - sandy		20	31	12. Pumping level below land surfaces: 22 ft. after 1 hrs. pumping 20 g.p.m. ft. after <input type="checkbox"/> hrs. pumping <input type="checkbox"/> g.p.m. Estimated maximum yield 80 g.p.m.	
SAND - med course		31	43	13. Water sample submitted: <input type="checkbox"/> mo./day/yr. Yes <input checked="" type="checkbox"/> No <input type="checkbox"/> Date <input type="checkbox"/>	
Course SAND		43	48	14. Well head completion: Pitless adapter 24 inches above grade	
grey green soft shale		48	48	15. Well grouted? <input checked="" type="checkbox"/> With: <input checked="" type="checkbox"/> Neat cement <input type="checkbox"/> Bentonite <input type="checkbox"/> Concrete Depth: From 10 ft. to 0 ft.	
(Use a second sheet if needed)				16. Nearest source of possible contamination: ft. 41' Direction N Type Sewer Well disinfected upon completion? <input type="checkbox"/> Yes <input checked="" type="checkbox"/> No	
18. Elevation:		19. Remarks:		17. Pump: Not installed Manufacturer's name Dempster Model number DM-33-SR 1/2 Volts 220 Length of drop pipe 40 ft. capacity 15 g.p.m. Type: <input checked="" type="checkbox"/> Submersible <input type="checkbox"/> Turbine <input type="checkbox"/> Jet <input type="checkbox"/> Reciprocating <input type="checkbox"/> Centrifugal <input type="checkbox"/> Other	
Topography: <input type="checkbox"/> Hill <input type="checkbox"/> Slope <input type="checkbox"/> Upland <input type="checkbox"/> Valley				20. Water well contractor's certification: This well was drilled under my jurisdiction and this report is true to the best of my knowledge and belief. PAUL'S INC #125 Business name Hessman, KNS License No. 6-22 Address Paul Bussch Signed Paul Bussch Date 6-22 Authorized representative	