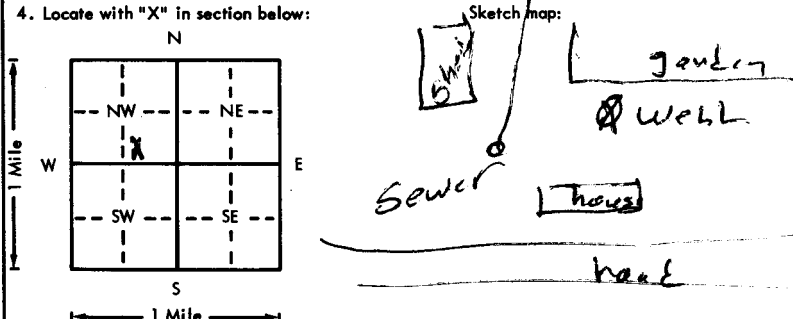


USE TYPEWRITER OR BALL
POINT PEN-PRESS FIRMLY,
PRINT CLEARLY.

WATER WELL RECORD
KSA 82a-1201-1215

Kansas Department of Health and
Environment-Division of Environment
(Water well Contractors)
Topeka, Kansas 66620

1. Location of well:	County HARVEY	Fraction SW 1/4 SE 1/4 NW 1/4	Section number 35	Township number T 23	Range number S R 2 E
2. Distance and direction from nearest town or city: Street address of well location if in city: Some			3. Owner of well: Don Moulis R.R. or street: 420 North St. City, state, zip code: HALSTEAD, KANS		
4. Locate with "X" in section below: 			6. Bore hole dia. 4 in. Completion date 7/26/76 Well depth 44 ft.		
			7. <input checked="" type="checkbox"/> Cable tool <input checked="" type="checkbox"/> Rotary <input type="checkbox"/> Driven <input type="checkbox"/> Dug <input type="checkbox"/> Hollow rod <input type="checkbox"/> Jetted <input type="checkbox"/> Bored <input type="checkbox"/> Reverse rotary		
			8. Use: <input type="checkbox"/> Domestic <input type="checkbox"/> Public supply <input type="checkbox"/> Industry <input checked="" type="checkbox"/> Irrigation <input type="checkbox"/> Air conditioning <input type="checkbox"/> Stock <input checked="" type="checkbox"/> Lawn <input type="checkbox"/> Oil field water <input type="checkbox"/> Other		
			9. Casing: Material PVC Height: Above or below Threaded <input type="checkbox"/> Welded <input checked="" type="checkbox"/> Surface 12 in. RMP <input type="checkbox"/> PVC <input checked="" type="checkbox"/> Weight 3.23 lbs./ft. Dia. 5 in. to 44 ft. depth Wall Thickness: inches or Dia. <input type="checkbox"/> in. to <input type="checkbox"/> ft. depth gage No. 2255		
5. Type and color of material			From	To	10. Screen: Manufacturer's name Robin Tech - own slot
top loam			0	3	Type PVC Dia. 5"
dark brown clay			3	10	Slot/gauze 20/64 Length 20
light brown clay			10	17	Set between 24 ft. and 44 ft.
grey clay			17	23	Gravel pack? <input checked="" type="checkbox"/> Size range of material 1/8-1/4
small to med. sand			23	40	11. Static water level: 16 1/2 ft. below land surface Date 7/27/76
coarse sand			40	43	12. Pumping level below land surfaces: 19 ft. after 1 hrs. pumping 20 g.p.m. ft. after hrs. pumping g.p.m. Estimated maximum yield 60 g.p.m.
grey clay			43	44	13. Water sample submitted: Yes <input checked="" type="checkbox"/> No <input type="checkbox"/> Date
					14. Well head completion: Pitless adapter 12 inches above grade
					15. Well grouted? <input checked="" type="checkbox"/> With: <input checked="" type="checkbox"/> Neat cement <input type="checkbox"/> Bentonite <input type="checkbox"/> Concrete Depth: From 0 ft. to 10 ft.
					16. Nearest source of possible contamination: house ft. 53 Direction west Type sewer Well disinfected upon completion? <input type="checkbox"/> Yes <input checked="" type="checkbox"/> No
					17. Pump: <input type="checkbox"/> Not installed Manufacturer's name Valley Model number 1208 HP 1/2 Volts 115 Length of drop pipe 34 ft. capacity 12 g.p.m. Type: <input checked="" type="checkbox"/> Submersible <input type="checkbox"/> Turbine <input type="checkbox"/> Jet <input type="checkbox"/> Reciprocating <input type="checkbox"/> Centrifugal <input type="checkbox"/> Other
					20. Water well contractor's certification: This well was drilled under my jurisdiction and this report is true to the best of my knowledge and belief. PAUL'S Inc 125 Business name License No. Address HESSMAN, KANS Signed Paul Budde Date 7/26/76 Authorized representative
18. Elevation:	19. Remarks:				
Topography: <input type="checkbox"/> Hill <input type="checkbox"/> Slope <input checked="" type="checkbox"/> Upland <input checked="" type="checkbox"/> Valley	(Use a second sheet if needed)				