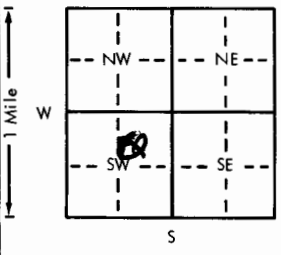
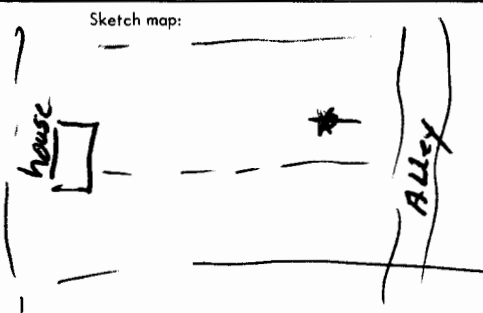


USE TYPEWRITER OR BALL  
POINT PEN-PRESS FIRMLY,  
PRINT CLEARLY.

WATER WELL RECORD  
KSA 82a-1201-1215

Kansas Department of Health and  
Environment-Division of Environment  
(Water well Contractors)  
Topeka, Kansas 66620

1. Location of well:		County <b>HARVEY</b>	Fraction <b>SW 1/4 NE 1/4 SW 1/4</b>	Section number <b>35</b>	Township number <b>T 23</b>	Range number <b>S R 2</b> <b>(W)</b>
2. Distance and direction from nearest town or city: Street address of well location if in city: <b>SAME</b>			3. Owner of well: <b>RICHARD Nightengale</b> R.R. or street: <b>306 College St</b> City, state, zip code: <b>Halstead, KANSAS</b>			
4. Locate with "X" in section below:		Sketch map:		6. Bore hole dia. <b>11</b> in. Completion date _____ Well depth <b>70</b> ft.		
				7. <input type="checkbox"/> Cable tool <input checked="" type="checkbox"/> Rotary <input type="checkbox"/> Driven <input type="checkbox"/> Dug <input type="checkbox"/> Hollow rod <input type="checkbox"/> Jetted <input type="checkbox"/> Bored <input type="checkbox"/> Reverse rotary		
5. Type and color of material		From	To	8. Use: <input type="checkbox"/> Domestic <input type="checkbox"/> Public supply <input type="checkbox"/> Industry <input checked="" type="checkbox"/> Irrigation <input type="checkbox"/> Air conditioning <input type="checkbox"/> Stock <input checked="" type="checkbox"/> Lawn <input type="checkbox"/> Oil field water <input type="checkbox"/> Other		
<b>LOAM to silty CLAY</b>		<b>0</b>	<b>12</b>	9. Casing: Material <b>plastic</b> Height <b>Above</b> Threaded <input type="checkbox"/> Welded <input checked="" type="checkbox"/> Surface <b>12</b> in. RMP <input type="checkbox"/> PVC <input checked="" type="checkbox"/> Weight <b>2.82</b> lbs./ft. Dia. <b>5</b> in. to <b>70</b> ft. depth Wall Thickness: inches or Dia. _____ in. to _____ ft. depth gage No. <b>125B</b>		
<b>FINE BROWN SAND</b>		<b>12</b>	<b>25</b>	10. Screen: Manufacturer's name <b>pumpco</b> Type <b>plastic</b> Dia. <b>5</b> Slot/gauze <b>1020</b> Length <b>10</b> Set between <b>60</b> ft. and <b>70</b> ft. Gravel pack? <input checked="" type="checkbox"/> Size range of material <b>40-44</b>		
<b>Blue soft GREY CLAY</b>		<b>25</b>	<b>45</b>	11. Static water level: _____ mo./day/yr. <b>18</b> ft. below land surface Date <b>6/18/79</b>		
<b>SANDY &amp; GREY CLAY</b>		<b>45</b>	<b>58</b>	12. Pumping level below land surfaces: _____ ft. after _____ hrs. pumping _____ g.p.m. <b>40</b> ft. after <b>2</b> hrs. pumping <b>20</b> g.p.m. Estimated maximum yield <b>30/40</b> g.p.m.		
<b>COMPACTED SAND-GRAVEL</b>		<b>58</b>	<b>68</b>	13. Water sample submitted: _____ mo./day/yr. Yes <input checked="" type="checkbox"/> No <input type="checkbox"/> Date _____		
<b>GREY/blue CLAY</b>		<b>68</b>	<b>72</b>	14. Well head completion: _____ Pitless adapter <b>12</b> inches above grade		
				15. Well grouted? <input checked="" type="checkbox"/> With: <input checked="" type="checkbox"/> Neat cement _____ Bentonite _____ Concrete _____ Depth: From <b>11</b> ft. to <b>0</b> ft.		
				16. Nearest source of possible contamination: <b>high</b> ft. <b>10</b> Direction <b>S</b> Type <b>house sewer line</b> Well disinfected upon completion? _____ Yes _____ No		
				17. Pump: _____ Not installed Manufacturer's name <b>Dempster</b> Model number <b>C203-5052-1/2</b> volts <b>208</b> Length of drop pipe <b>55</b> ft. capacity <b>20</b> g.p.m. Type: <input checked="" type="checkbox"/> Submersible _____ Turbine _____ Jet _____ Reciprocating _____ Centrifugal _____ Other		
18. Elevation:		19. Remarks: <b>grout by owner</b>		20. Water well contractor's certification: This well was drilled under my jurisdiction and this report is to the best of my knowledge and belief. <b>PAULUS Inc</b> <b>#175</b> Business name _____ License No. _____ Address <b>Box 26 Hess, TX</b> Signed <b>Paul Paulus</b> Date <b>6/20/79</b> Authorized representative		