


1 LOCATION OF WATER WELL:		Fraction	Section Number	Township Number	Range Number
County: <u>Harvey</u>		<u>SW 1/4</u> <u>NW 1/4</u> <u>SW 1/4</u>	<u>35</u>	<u>T</u> <u>23S</u>	<u>R</u> <u>2-</u>
Distance and direction from nearest town or city street address of well if located within city?					

3 LOCATE WELL'S LOCATION WITH AN "X" IN SECTION BOX: N

4 DEPTH OF COMPLETED WELL..... 45. ft. ELEVATION:

Depth(s) Groundwater Encountered 1. ft. 2. ft. 3. ft.

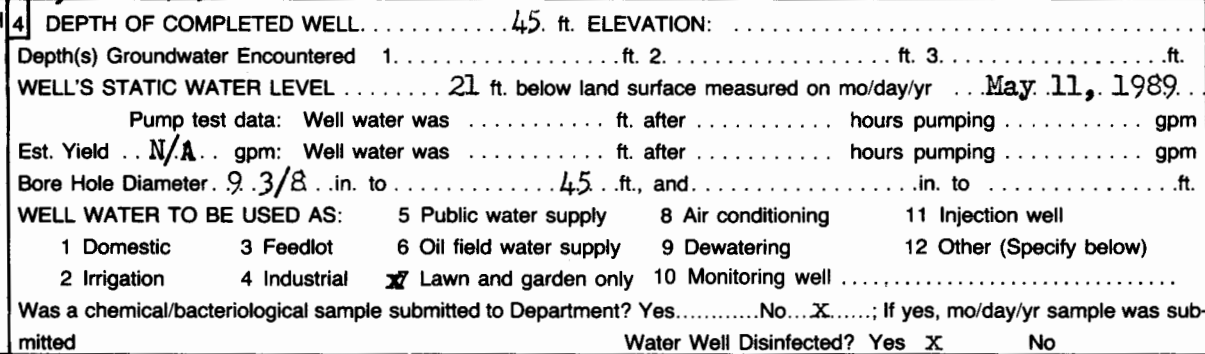

6 GROUT MATERIAL:		1 Neat cement	2 Cement grout	3 Bentonite	4 Other
Grout Intervals:		From 3 ft. to 22 ft.	From ft. to ft.	From ft. to ft.	From ft. to ft.
What is the nearest source of possible contamination:					
1 Septic tank	4 Lateral lines	7 Pit privy	10 Livestock pens	14 Abandoned water well	
2 Sewer lines	5 Cess pool	8 Sewage lagoon	11 Fuel storage	15 Oil well/Gas well	
3 Watertight sewer lines	6 Seepage pit	9 Feedyard	12 Fertilizer storage	16 Other (specify below)	
			13 Insecticide storage	None	
Direction from well?			How many feet?		

7 CONTRACTOR'S OR LANDOWNER'S CERTIFICATION: This water well was (1) constructed, (2) reconstructed, or (3) plugged under my jurisdiction and completed on (mo/day/year) 31 May 11, 1989 and this record is true to the best of my knowledge and belief. K2 Water Well Contractor's License No. 134 This Water Well Record was completed on (mo/day/yr) May 11, 1989 under the business name of Rosencrantz-Bemis Enterprise by (signature) Steve Dodson

INSTRUCTIONS: Use typewriter or ball point pen. PLEASE PRESS FIRMLY and PRINT clearly. Please fill in blanks, underline or circle the correct answers. Send top three copies to Kansas Department of Health and Environment, Bureau of Water Protection, Topeka, Kansas 66620-7320. Telephone: 913-296-5514. Send one to WATER WELL OWNER and retain one for your records.