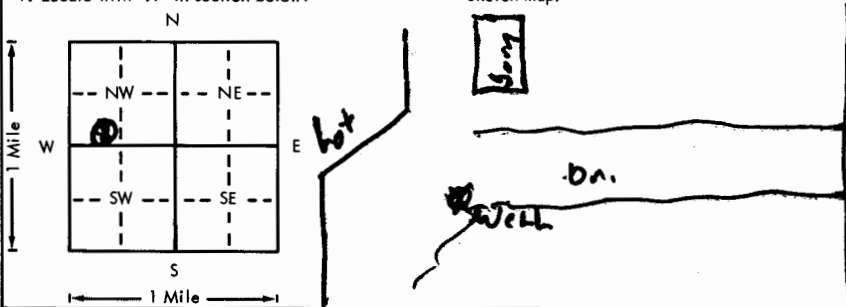


USE TYPEWRITER OR BALL
POINT PEN-PRESS FIRMLY,
PRINT CLEARLY.

WATER WELL RECORD
KSA 82a-1201-1215

Kansas Department of Health and
Environment-Division of Environment
(Water well Contractors)
Topeka, Kansas 66620

1. Location of well:		County HARVEY	Fraction SE 1/4 SW 1/4 NW 1/4	Section number 36	Township number T 23 S R 2 E	Range number 2 E
2. Distance and direction from nearest town or city: Street address of well location if in city: North-Street				3. Owner of well: WALDO JANZEN R.R. or street: 209 LOCUST City, state, zip code: HelisTeak, KANS		
4. Locate with "X" in section below:		Sketch map:		6. Bore hole dia. 1 in. Completion date 7-21-77 Well depth 53 ft.		
				7. <input checked="" type="checkbox"/> Cable tool <input checked="" type="checkbox"/> Rotary <input type="checkbox"/> Driven <input type="checkbox"/> Dug <input type="checkbox"/> Hollow rod <input type="checkbox"/> Jetted <input type="checkbox"/> Bored <input type="checkbox"/> Reverse rotary		
5. Type and color of material		From		To		8. Use: <input type="checkbox"/> Domestic <input type="checkbox"/> Public supply <input type="checkbox"/> Industry <input checked="" type="checkbox"/> Irrigation <input type="checkbox"/> Air conditioning <input type="checkbox"/> Stock <input checked="" type="checkbox"/> Lawn <input type="checkbox"/> Oil field water <input type="checkbox"/> Other
SANDY Loam		1		5		9. Casing: Material plastic Height Above or below Threaded <input type="checkbox"/> Welded <input type="checkbox"/> Surface 18 in. RMP <input type="checkbox"/> PVC <input checked="" type="checkbox"/> Weight <input type="checkbox"/> lbs./ft.
red clay		5		10		Dia. 5 in. to 53 ft. depth Wall Thickness: inches or Dia. <input type="checkbox"/> in. to <input type="checkbox"/> ft. depth gage No. 2258
red - brown clay + fine sand		10		15		10. Screen: Manufacturer's name RobinsTech - main slot Type PVC Dia. 5 Slot/gauze 0046 Length 20 Set between 33 ft. and 53 ft. Gravel pack? <input checked="" type="checkbox"/> Size range of material 1/2-1/4
brown clay		15		20		11. Static water level: 17 ft. below land surface Date 7-21-77
brown clay - sand		20		25		12. Pumping level below land surfaces: 19 ft. after 1 hrs. pumping 20 g.p.m. ft. after <input type="checkbox"/> hrs. pumping <input type="checkbox"/> g.p.m. Estimated maximum yield 150 g.p.m.
med sand		25		30		13. Water sample submitted: <input checked="" type="checkbox"/> Yes <input type="checkbox"/> No Date <input type="checkbox"/>
fine to coarse sand		30		35		14. Well head completion: <input type="checkbox"/> Pitless adapter 18 inches above grade
sand med to coarse		35		50		15. Well grouted? NO With: <input type="checkbox"/> Neat cement <input type="checkbox"/> Bentonite <input type="checkbox"/> Concrete Depth: From <input type="checkbox"/> ft. to <input type="checkbox"/> ft.
gray clay		50		53		16. Nearest source of possible contamination: Small feed lot ft. 30 Direction NW Type feed lot Well disinfected upon completion? <input type="checkbox"/> Yes <input type="checkbox"/> No
						17. Pump: <input checked="" type="checkbox"/> Not installed Manufacturer's name <input type="checkbox"/> Model number <input type="checkbox"/> HP <input type="checkbox"/> Volts <input type="checkbox"/> Length of drop pipe <input type="checkbox"/> ft. capacity <input type="checkbox"/> g.p.m. Type: <input type="checkbox"/> Submersible <input type="checkbox"/> Turbine <input type="checkbox"/> Jet <input type="checkbox"/> Reciprocating <input type="checkbox"/> Centrifugal <input type="checkbox"/> Other
(Use a second sheet if needed)						
18. Elevation:		19. Remarks:		20. Water well contractor's certification:		
Topography: <input type="checkbox"/> Hill <input type="checkbox"/> Slope <input type="checkbox"/> Upland <input type="checkbox"/> Valley		owner to grant well		This well was drilled under my jurisdiction and this report is true to the best of my knowledge and belief. PAULIS INC #175 Business name HESTON, KANS License No. Address Paul B. Heston Date 8/24/77 Signed Paul B. Heston Authorized Representative		