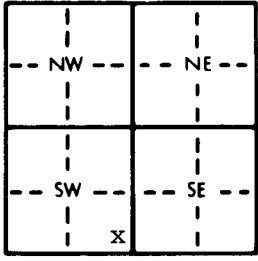


1 LOCATION OF WELL: County: Harvey Fraction SE 1/4 SE 1/4 SW 1/4 Section Number 29 Township Number T 23 S Range Number R 2 E/W

Distance and direction from nearest town or city street address of well if located within city?
Approximately 1 mile north and 3 miles west of Halstead

2 WATER WELL OWNER: City of Wichita
RR#, St. Address, Box # : 455 N. Main Board of Agriculture, Division of Water Resources
City, State, ZIP Code : Wichita, KS 67202 Application Number:


3 LOCATE WELL'S LOCATION WITH AN "X" IN SECTION BOX:

4 DEPTH OF COMPLETED WELL: 204 ft. ELEVATION: unknown
Depth(s) Groundwater Encountered 1. ft. 2. ft. 3. ft.
WELL'S STATIC WATER LEVEL not ch'd ft. below land surface measured on mo/day/yr
Pump test data: Well water was not ch'd ft. after hours pumping gpm
Est. Yield unknown gpm: Well water was ft. after hours pumping gpm
Bore Hole Diameter... 6 in. to 215 ft., and in. to ft.
WELL WATER TO BE USED AS: 5 Public water supply 8 Air conditioning 11 Injection well
1 Domestic 3 Feedlot 6 Oil field water supply 9 Dewatering basin 12 Other (Specify below)
2 Irrigation 4 Industrial 7 Lawn and garden only 10 Monitoring well Recharge Well
Was a chemical/bacteriological sample submitted to Department? Yes.....No X.....; If yes, mo/day/yr sample was submitted
Water Well Disinfected? Yes No X

5 TYPE OF BLANK CASING USED: 1 Steel 3 RMP (SR) 5 Wrought iron 8 Concrete tile CASING JOINTS: Glued X Clamped
2 PVC 4 ABS 6 Asbestos-Cement 9 Other (specify below) Welded
7 Fiberglass Threaded
Blank casing diameter 2 in. to 57 ft., Dia in. to ft., Dia in. to ft.
Casing height above land surface 24 in., weight 96 lbs./ft. Wall thickness or gauge No. 218
TYPE OF SCREEN OR PERFORATION MATERIAL: 7 PVC 10 Asbestos-cement
1 Steel 3 Stainless steel 5 Fiberglass 8 RMP (SR) 11 Other (specify)
2 Brass 4 Galvanized steel 6 Concrete tile 9 ABS 12 None used (open hole)
SCREEN OR PERFORATION OPENINGS ARE: 5 Gauzed wrapped 8 Saw cut 11 None (open hole)
1 Continuous slot 3 Mill slot 6 Wire wrapped 9 Drilled holes
2 Louvered shutter 4 Key punched 7 Torch cut 10 Other (specify)
SCREEN-PERFORATED INTERVALS: From 57 ft. to 202 ft., From ft. to ft.
From ft. to ft., From ft. to ft.
GRAVEL PACK INTERVALS: From 52 ft. to 215 ft., From ft. to ft.
From ft. to ft., From ft. to ft.

6 GROUT MATERIAL: 1 Neat cement 2 Cement grout 3 Bentonite 4 Other Bentonite Holeplug
Grout intervals: From 0 ft. to 32 ft., From ft. to ft., From ft. to 32 ft., From ft. to 52 ft.
What is the nearest source of possible contamination:
1 Septic tank 4 Lateral lines 7 Pit privy 10 Livestock pens 14 Abandoned water well
2 Sewer lines 5 Cess pool 8 Sewage lagoon 11 Fuel storage 15 Oil well/Gas well
3 Watertight sewer lines 6 Seepage pit 9 Feedyard 12 Fertilizer storage 16 Other (specify below)
13 Insecticide storage None known
Direction from well? How many feet?

FROM	TO	LITHOLOGIC LOG	FROM	TO	PLUGGING INTERVALS
0	7	Sand, medium, fine, very fine	122	124	Clay, green
7	14	Sand and gravel, medium, fine, very fine	124	154	Sand and gravel, medium, fine, very fine
14	37	Clay, gray, green	154	156	Clay, tan
37	46	Sand, medium, fine, very fine	156	197	Sand and gravel, medium, fine, very fine
46	67	Clay, brown, hard, sand streaks			
67	71	Clay, green, hard	197	207	Clay, dark green
71	82	Sand and gravel, medium, fine, very fine	207	215	Shale, black
82	102	Clay, green, hard			
102	110	Sand and gravel, medium, fine, very fine			
110	112	Clay, green			
112	122	Sand and gravel, medium, fine, very fine			

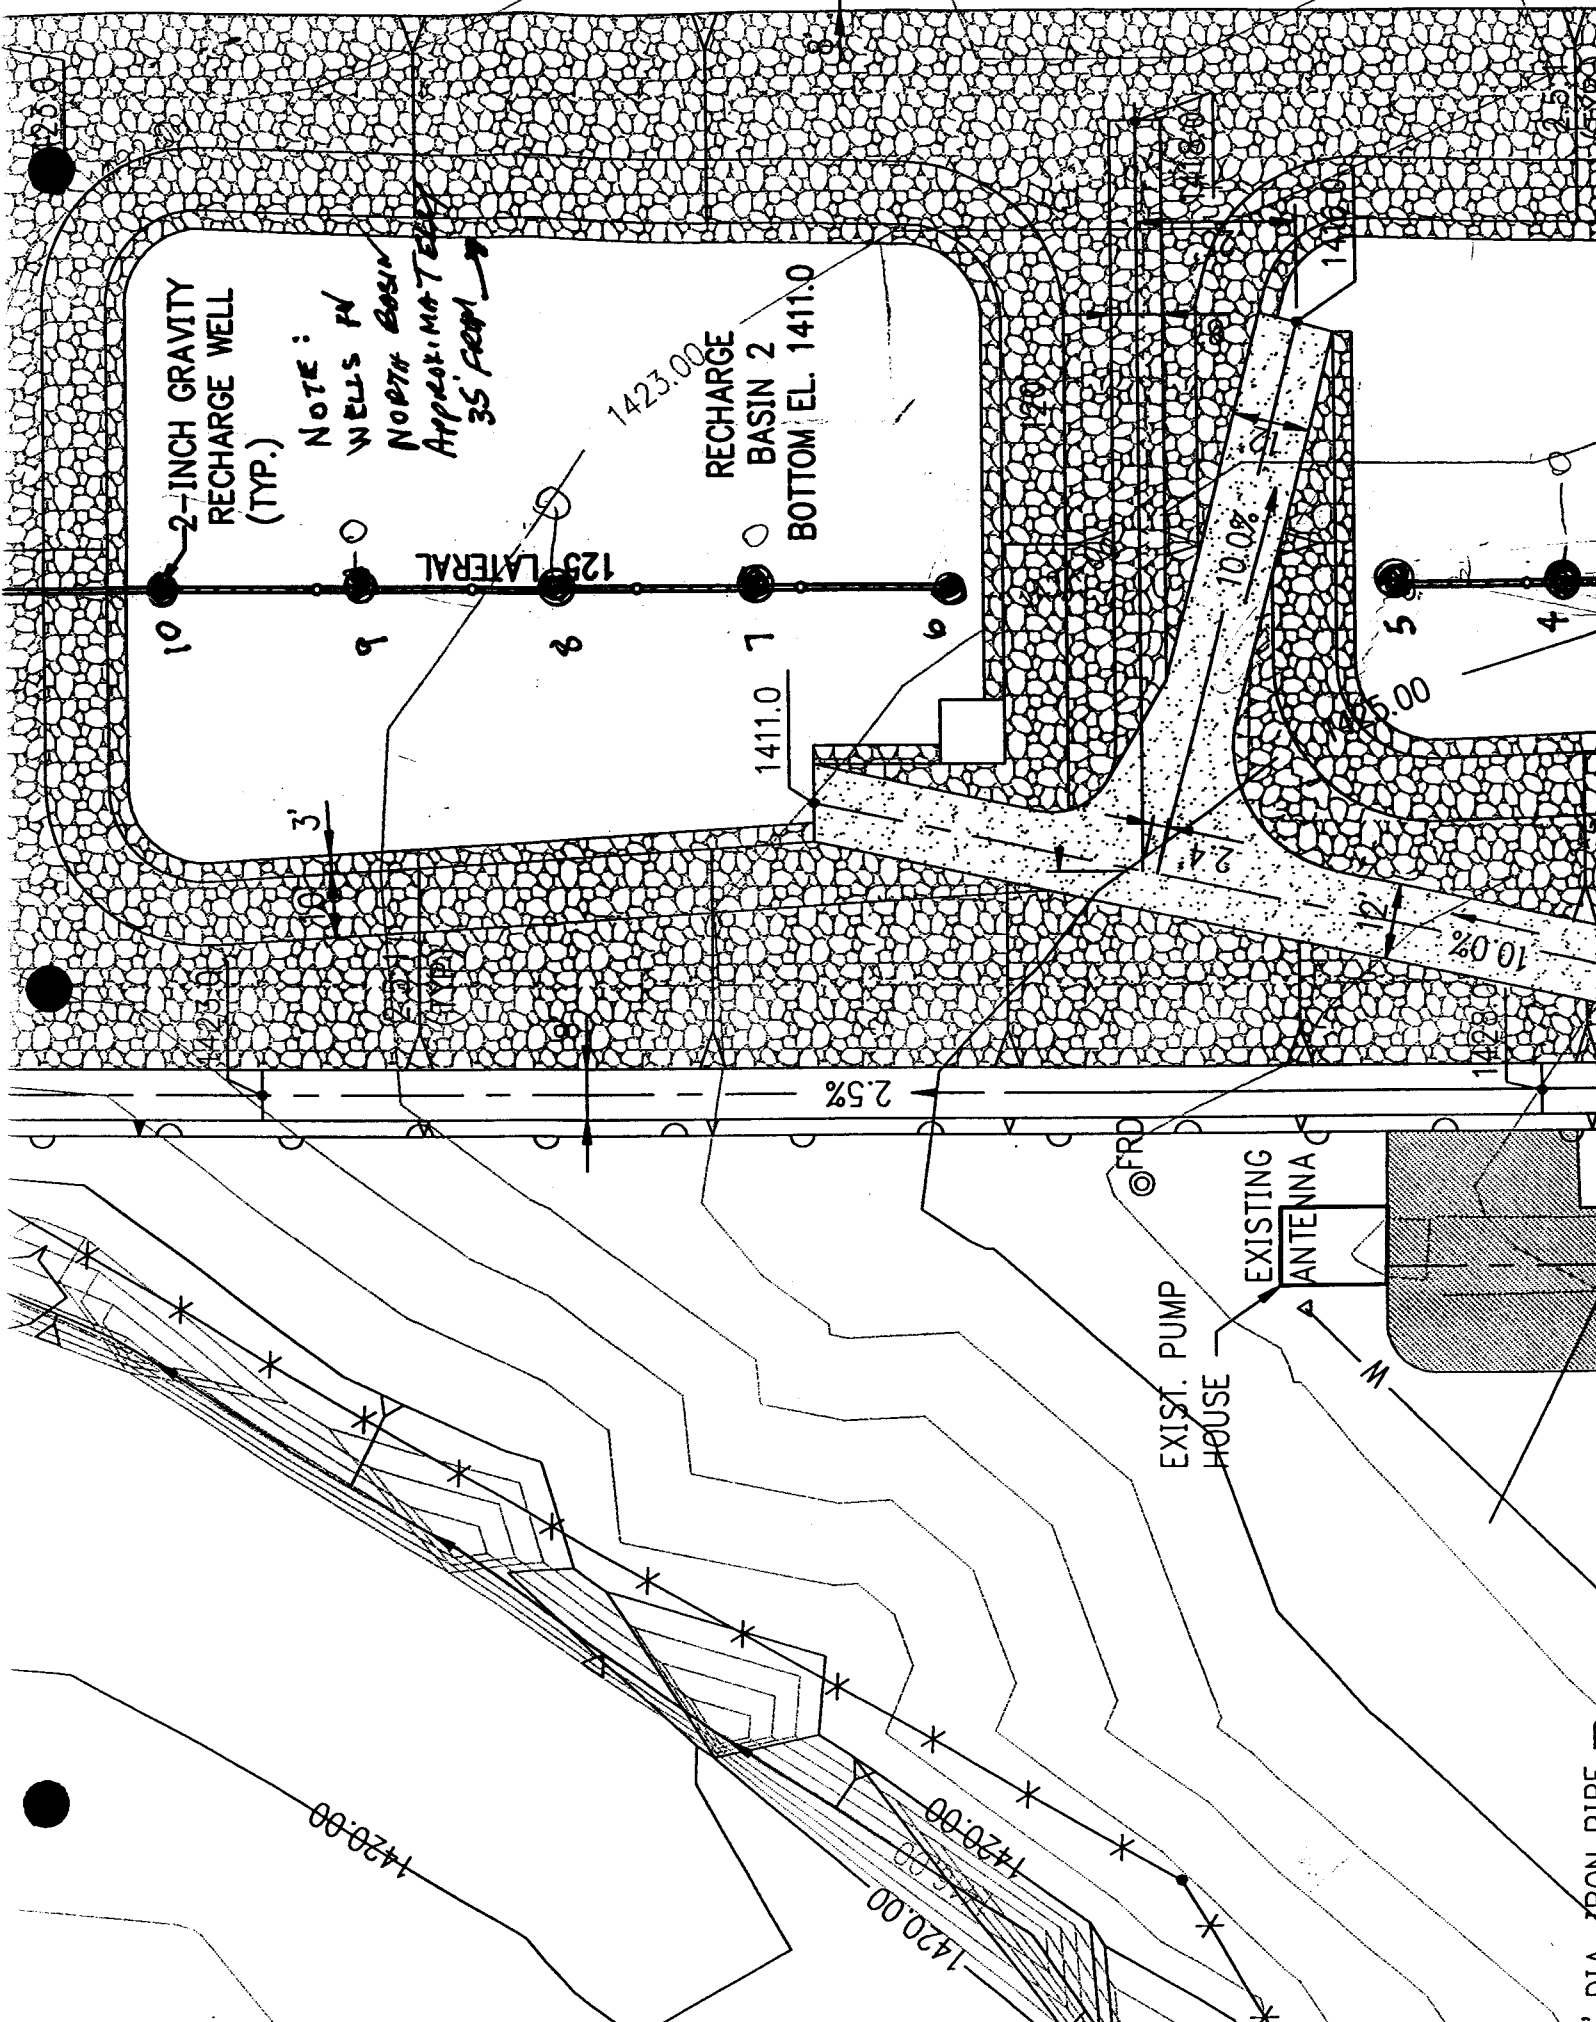7 CONTRACTOR'S OR LANDOWNER'S CERTIFICATION: This water well was (1) constructed, (2) reconstructed, or (3) plugged under my jurisdiction and was completed on (mo/day/year) 10-14-99 and this record is true to the best of my knowledge and belief. Kansas Water Well Contractor's License No. 185 This Water Well Record was completed on (mo/day/yr) 10-22-99 under the business name of Clarke Well & Equipment, Inc. by (signature) Clarke Well & Equipment, Inc.



2-INCH GRAVITY
RECHARGE WELL
(TYP.)

NOTE:
WELLS IN
NORTH BASIN
35' FROM

RECHARGE
BASIN 2
BOTTOM EL. 1411.0

125' LATERAL

EXIST. PUMP
HOUSE

EXISTING
ANTENNA

1" DIA. IRON PIPE

