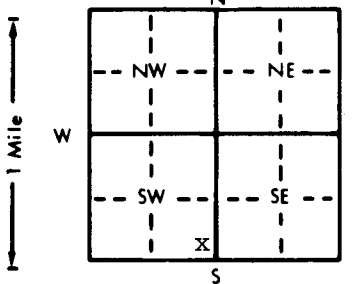


1 LOCATION OF WATER WELL:		Fraction	Section Number		Township Number	Range Number
County: Harvey		SE 1/4 SE 1/4 SW 1/4	29		T 23 S	R 2 E/W
Distance and direction from nearest town or city street address of well if located within city? Approximately 1 mile north and 3 miles west of Halstead						
2 WATER WELL OWNER:		City of Wichita				
RR#, St. Address, Box # :		455 N. Main				
City, State, ZIP Code :		Wichita, KS 67202				
Board of Agriculture, Division of Water Resources		Application Number:				
3 LOCATE WELL'S LOCATION WITH AN "X" IN SECTION BOX:		4 DEPTH OF COMPLETED WELL: 204 ft. ELEVATION: unknown				
		Depth(s) Groundwater Encountered 1. ft. 2. ft. 3. ft. WELL'S STATIC WATER LEVEL not ch'd ft. below land surface measured on mo/day/yr Pump test data: Well water was not ch'd ft. after hours pumping gpm Est. Yield unknown gpm: Well water was ft. after hours pumping gpm Bore Hole Diameter: 6 in. to 215 ft., and in. to ft. WELL WATER TO BE USED AS: 5 Public water supply 8 Air conditioning 11 Injection well 1 Domestic 3 Feedlot 6 Oil field water supply 9 Dewatering Basin 12 Other (Specify below) 2 Irrigation 4 Industrial 7 Lawn and garden only 10 Monitoring well Recharge Well Was a chemical/bacteriological sample submitted to Department? Yes No X; If yes, mo/day/yr sample was submitted Water Well Disinfected? Yes No X				
5 TYPE OF BLANK CASING USED:		CASING JOINTS: Glued Clamped				
1 Steel 3 RMP (SR)		5 Wrought iron 8 Concrete tile				
2 PVC 4 ABS		6 Asbestos-Cement 9 Other (specify below) Welded				
Blank casing diameter 2 in. to 57 ft. Dia. in. to ft. Dia. in. to ft.		7 Fiberglass Threaded				
Casing height above land surface 24 in., weight .96 lbs./ft. Wall thickness or gauge No. 218						
TYPE OF SCREEN OR PERFORATION MATERIAL:		7 PVC 10 Asbestos-cement				
1 Steel 3 Stainless steel 5 Fiberglass 8 RMP (SR) 11 Other (specify)		12 None used (open hole)				
2 Brass 4 Galvanized steel 6 Concrete tile 9 ABS						
SCREEN OR PERFORATION OPENINGS ARE:		5 Gauzed wrapped 8 Saw cut 11 None (open hole)				
1 Continuous slot 3 Mill slot 6 Wire wrapped 9 Drilled holes						
2 Louvered shutter 4 Key punched 7 Torch cut 10 Other (specify)						
SCREEN-PERFORATED INTERVALS: From 57 ft. to 202 ft. From ft. to ft.						
GRAVEL PACK INTERVALS: From 52 ft. to 215 ft. From ft. to ft.						
6 GROUT MATERIAL: Sand Neat cement 2 Cement grout 3 Bentonite 4 Other Bentonite Holeplug						
Grout intervals: From 0 ft. to 32 ft. From ft. to ft. From 32 ft. to 52 ft.						
What is the nearest source of possible contamination:		10 Livestock pens 14 Abandoned water well				
1 Septic tank 4 Lateral lines 7 Pit privy 11 Fuel storage 15 Oil well/Gas well		12 Fertilizer storage 16 Other (specify below)				
2 Sewer lines 5 Cess pool 8 Sewage lagoon 13 Insecticide storage None known						
3 Watertight sewer lines 6 Seepage pit 9 Feedyard						
Direction from well?		How many feet?				
FROM	TO	LITHOLOGIC LOG	FROM	TO	PLUGGING INTERVALS	
0	9	Sand, medium, fine, very fine	127	129	Clay, green	
9	14	Sand and gravel, medium, fine, very fine	129	153	Sand and gravel, medium, fine, very fine	
14	37	Clay, gray, green	153	159	Clay, tan	
37	45	Sand, medium, fine, very fine	159	197	Sand and gravel, medium, fine, very fine	
45	67	Clay, brown, sand streaks				
67	72	Clay, green, hard	197	206	Clay, dark green	
72	80	Sand and gravel, medium, fine, very fine	206	215	Shale, black	
80	104	Clay, green				
104	109	Sand and gravel, medium, fine, very fine				
109	114	Clay, green				
114	127	Sand and gravel, medium, fine, very fine				
7 CONTRACTOR'S OR LANDOWNER'S CERTIFICATION: This water well was (1) constructed, (2) reconstructed, or (3) plugged under my jurisdiction and was completed on (mo/day/year) 10-15-99 and this record is true to the best of my knowledge and belief. Kansas Water Well Contractor's License No. 185 This Water Well Record was completed on (mo/day/yr) 10-22-99 under the business name of Clarke Well & Equipment, Inc. by (signature) 