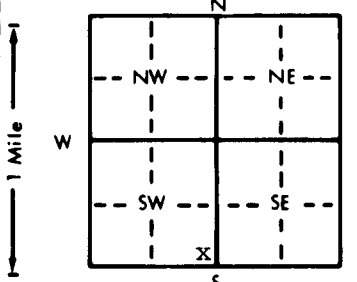


1 LOCATION OF WATER WELL:		Fraction		Section Number		Township Number		Range Number	
County: <u>Harvey</u>		SE 1/4 SE 1/4 SW 1/4		29		T 23 S		R 2 E/W	
Distance and direction from nearest town or city street address of well if located within city? <u>Approximately 1 mile north and 3 miles west of Halstead</u>									
2 WATER WELL OWNER:		City of Wichita							
RR#, St. Address, Box # :		455 N. Main							
City, State, ZIP Code :		Wichita, KS 67202							
3 LOCATE WELL'S LOCATION WITH AN "X" IN SECTION BOX:		4 DEPTH OF COMPLETED WELL		204		ft. ELEVATION:		unknown	
		Depth(s) Groundwater Encountered 1. ft. 2. ft. 3. ft.							
		WELL'S STATIC WATER LEVEL <u>not ch'd</u> ft. below land surface measured on mo/day/yr							
		Pump test data: Well water was <u>not ch'd</u> ft. after hours pumping gpm							
		Est. Yield <u>unknown</u> gpm: Well water was ft. after hours pumping gpm							
		Bore Hole Diameter . . . 6 . . . in. to . . . 215 . . . ft., and in. to ft.							
WELL WATER TO BE USED AS:		5 Public water supply		8 Air conditioning		11 Injection well			
1 Domestic		3 Feedlot		6 Oil field water supply		9 Dewatering		12 Other (Specify below)	
2 Irrigation		4 Industrial		7 Lawn and garden only		10 Monitoring well		Basin Recharge Well	
Was a chemical/bacteriological sample submitted to Department? Yes No X If yes, mo/day/yr sample was submitted									
Water Well Disinfected? Yes No X									
5 TYPE OF BLANK CASING USED:									
1 Steel 3 RMP (SR) 5 Wrought iron 8 Concrete tile CASING JOINTS: Glued . . . X . . . Clamped									
2 PVC 4 ABS 6 Asbestos-Cement 9 Other (specify below) Welded									
7 Fiberglass Threaded									
Blank casing diameter 2 in. to 55 ft., Dia in. to ft., Dia in. to ft.									
Casing height above land surface 24 in., weight 96 lbs./ft. Wall thickness or gauge No. . . . 218									
TYPE OF SCREEN OR PERFORATION MATERIAL:									
1 Steel 3 Stainless steel 5 Fiberglass 7 PVC 10 Asbestos-cement									
2 Brass 4 Galvanized steel 6 Concrete tile 8 RMP (SR) 11 Other (specify)									
9 ABS 12 None used (open hole)									
SCREEN OR PERFORATION OPENINGS ARE:									
1 Continuous slot 3 Mill slot 5 Gauzed wrapped 8 Saw cut 11 None (open hole)									
2 Louvered shutter 4 Key punched 6 Wire wrapped 9 Drilled holes									
7 Torch cut 10 Other (specify)									
SCREEN-PERFORATED INTERVALS: From . . . 55 . . . ft. to . . . 202 . . . ft., From ft. to ft.									
From ft. to ft., From ft. to ft.									
GRAVEL PACK INTERVALS: From . . . 54 . . . ft. to . . . 215 . . . ft., From ft. to ft.									
From ft. to ft., From ft. to ft.									
6 GROUT MATERIAL: 1 Block cement 2 Cement grout 3 Bentonite 4 Other <u>Bentonite Holeplug</u>									
Grout Intervals: From <u>Sand & Gravel</u> 0 . . . ft. to . . . 4 . . . ft., From ft. to ft., From . . . 4 . . . ft. to . . . 54 . . . ft.									
What is the nearest source of possible contamination:									
1 Septic tank 4 Lateral lines 7 Pit privy 10 Livestock pens 14 Abandoned water well									
2 Sewer lines 5 Cess pool 8 Sewage lagoon 11 Fuel storage 15 Oil well/Gas well									
3 Watertight sewer lines 6 Seepage pit 9 Feedyard 12 Fertilizer storage 16 Other (specify below)									
13 Insecticide storage None known									
Direction from well? How many feet?									
FROM TO LITHOLOGIC LOG FROM TO PLUGGING INTERVALS									
0 9 Sand, medium, fine, very fine 146 147 Clay, green									
9 13 Sand and gravel, medium, fine, very fine 147 153 Sand nad gravel, medium, fine									
153 164 Clay, tan									
13 39 Clay, gray, green 164 203 Sand and gravel, medium, fine									
39 46 Sand, medium, fine, very fine 203 209 Clay, dark green									
46 70 Clay, brown, sand streaks 209 215 Shale, black									
70 91 Sand and gravel, medium, fine									
91 104 Clay, green									
104 115 Sand and gravel, medium, fine, very fine									
115 119 Clay, green									
119 123 Sand and gravel, medium, fine, very fine									
123 127 Clay, green									
127 146 Sand and gravel, medium, fine, very fine									
7 CONTRACTOR'S OR LANDOWNER'S CERTIFICATION: This water well was (1) constructed, (2) reconstructed, or (3) plugged under my jurisdiction and was completed on (mo/day/year) 10-20-99 and this record is true to the best of my knowledge and belief. Kansas Water Well Contractor's License No. . . . 185 This Water Well Record was completed on (mo/day/yr) . . . 10-27-99 . . . under the business name of <u>Clarke Well & Equipment, Inc.</u> by (signature) <u>Clarke Well & Equipment, Inc.</u>									
INSTRUCTIONS: Use typewriter or ball point pen. PLEASE PRESS FIRMLY and PRINT clearly. Please fill in blanks, underline or circle the correct answers. Send top three copies to Kansas Department of Health and Environment, Bureau of Water, Topeka, Kansas 66620-0001. Telephone: 913-296-5545. Send one to WATER WELL OWNER and retain one for your records.									