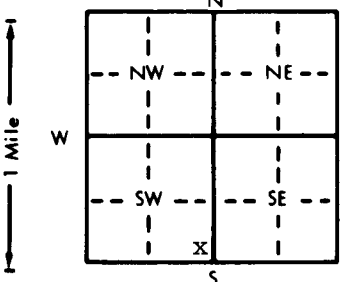


1 LOCATION OF WATER WELL:		Fraction		Section Number		Township Number		Range Number	
County: Harvey		SE 1/4 SE 1/4 SW 1/4		29		T 23 S		R 2 EW	
Distance and direction from nearest town or city street address of well if located within city? Approximately 1 mile north and 3 miles west of Halstead									
2 WATER WELL OWNER:		City of Wichita							
RR#, St. Address, Box # :		455 N. Main							
City, State, ZIP Code :		Wichita, KS 67202							
3 LOCATE WELL'S LOCATION WITH AN "X" IN SECTION BOX:		4 DEPTH OF COMPLETED WELL: 200 ft. ELEVATION: unknown							
		Depth(s) Groundwater Encountered 1. ft. 2. ft. 3. ft.							
		WELL'S STATIC WATER LEVEL not ch'd ft. below land surface measured on mo/day/yr							
		Pump test data: Well water was not ch'd ft. after hours pumping gpm							
		Est. Yield unknown gpm: Well water was ft. after hours pumping gpm							
		Bore Hole Diameter .6 in. to .215 in. and in. to ft.							
TYPE OF BLANK CASING USED:		CASING JOINTS: Glued .X. Clamped .							
1 Steel		3 RMP (SR)		6 Asbestos-Cement		9 Other (specify below)		Welded .	
2 PVC		4 ABS		7 Fiberglass				Threaded .	
Blank casing diameter .2 in. to .60 ft. Dia . in. to . ft. Dia . in. to . ft.									
Casing height above land surface .24 in. weight .96 lbs./ft. Wall thickness or gauge No. .218									
TYPE OF SCREEN OR PERFORATION MATERIAL:		7 PVC 10 Asbestos-cement							
1 Steel		3 Stainless steel		5 Fiberglass		8 RMP (SR)		11 Other (specify) .	
2 Brass		4 Galvanized steel		6 Concrete tile		9 ABS		12 None used (open hole)	
SCREEN OR PERFORATION OPENINGS ARE:		5 Gauzed wrapped 8 Saw cut 11 None (open hole)							
1 Continuous slot		3 Mill slot		6 Wire wrapped		9 Drilled holes			
2 Louvered shutter		4 Key punched		7 Torch cut		10 Other (specify) .			
SCREEN-PERFORATED INTERVALS: From .60 ft. to .198 ft. From . ft. to . ft.									
GRAVEL PACK INTERVALS: From .59 ft. to .215 ft. From . ft. to . ft.									
6 GROUT MATERIAL:		1 Neat cement 2 Cement grout 3 Bentonite 4 Other Bentonite Holeplug							
Grout Intervals: From .0 ft. to .4 ft. From . ft. to . ft. From .4 ft. to .59 ft.									
What is the nearest source of possible contamination:		10 Livestock pens 14 Abandoned water well							
1 Septic tank		4 Lateral lines		7 Pit privy		11 Fuel storage		15 Oil well/Gas well	
2 Sewer lines		5 Cess pool		8 Sewage lagoon		12 Fertilizer storage		16 Other (specify below)	
3 Watertight sewer lines		6 Seepage pit		9 Feedyard		13 Insecticide storage		None known	
Direction from well?		How many feet?							
FROM TO LITHOLOGIC LOG FROM TO PLUGGING INTERVALS									
0 11 Sand, meidum, fine, very fine		207 215 Shale, black							
11 22 Clay, gray, green									
22 66 Clay, green, sand streak at 37'									
66 75 Sand and gravel, medium, fine									
75 104 Clay, green and white, sand streaks									
104 118 Sand and gravel, medium, fine									
118 125 Clay, green and tan									
125 153 Sand and gravel, medium, fine									
153 165 Clay, tan									
165 169 Sand and gravel, medium, fine									
169 173 Clay, green									
173 187 Sand and gravel, medium, fine									
187 193 Clay, green									
193 198 Sand and gravel, medium, fine									
198 207 Clay, dark green									
7 CONTRACTOR'S OR LANDOWNER'S CERTIFICATION: This water well was (1) constructed, (2) reconstructed, or (3) plugged under my jurisdiction and was completed on (mo/day/year) 10-22-99 and this record is true to the best of my knowledge and belief. Kansas Water Well Contractor's License No. 185 This Water Well Record was completed on (mo/day/yr) 10-27-99 under the business name of Clarke Well & Equipment, Inc. by (signature) [Signature]									
INSTRUCTIONS: Use typewriter or ball point pen. PLEASE PRESS FIRMLY and PRINT clearly. Please fill in blanks, underline or circle the correct answers. Send top three copies to Kansas Department of Health and Environment, Bureau of Water, Topeka, Kansas 66620-0001. Telephone: 913-296-5545. Send one to WATER WELL OWNER and retain one for your records.									

OFFICE USE ONLY

T

R

EW

SEC

1/4

1/4

1/4