

1	LOCATION OF WATER WELL:	Fraction	Section Number	Township Number	Range Number
County:	Harvey	SW ¼ SE ¼ SE ¼	35	T 23 S	R 2 E

Distance and direction from nearest town or city street address of well if located within city?

505 Main St in Halstead

2 WATER WELL OWNER: *Kansas Learning Center*

RR#, St. Address, Box # : 505 Main St


City, State, ZIP Code : Halstead KS 67056

Board of Agriculture, Division of Water Resources

Application Number:

3	LOCATE WELL'S LOCATION WITH	4	DEPTH OF COMPLETED WELL... <u>1.05</u> ft. ELEVATION:
---	-----------------------------	---	---

AN "X" IN SECTION BOX:

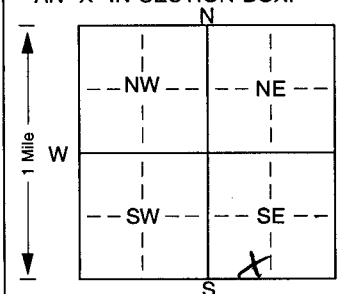

Depth(s) Groundwater Encountered 1. ft. 2. ft. 3. ft.

Depth(s) Groundwater Encountered 1. ft. 2. ft. 3. ft.
WELL'S STATIC WATER LEVEL 20 ft. below land surface measured on mo/day/yr 4-13-00

Pump test data: Well water was ... 2.2 ... ft. after ... 1 ... hours pumping ... 25 ... gpm

Est. Yield gpm: Well water was ft. after hours pumping gpm

Bore Hole Diameter. 8 in. to 106 ft., and _____ in. to _____ ft.

WELL WATER TO BE USED AS: 5 Public water supply 8 Air conditioning 11 Injection well

1 Domestic 3 Feedlot 6 Oil field water supply 9 Dewatering 12 Other (Specify below)

2 Irrigation 4 Industrial 7 Domestic (lawn & garden) 10 Monitoring well

Was a chemical/bacteriological sample submitted to Department? Yes. No. X . . . ; If yes, mo/day/yr sample was submitted
Water Well Disinfected? Yes X No

5	TYPE OF BLANK CASING USED:	5 Wrought iron	8 Concrete tile	CASING JOINTS: Glued. <input checked="" type="checkbox"/> Clamped. <input type="checkbox"/>
---	----------------------------	----------------	-----------------	---

1 Steel 3 RMP (SR) 6 Asbestos-Cement 9 Other (specify below) Welded

2 PVC 4 ABS 7 Fiberglass Threaded.....

Blank casing diameter 5 in. to 95 ft. Dia

Blank casing diameter 2 in. to 7 1/2 ft., Dia in. to ft., Dia in. to ft.

Casing height above land surface. . . . 1.2 in., weight 2.2 / lbs./ft. Wall thickness or gauge No. . . 165

TYPE OF SCREEN OR PERFORATION MATERIAL: 7 PVC 10 Asbestos-cement

1 Steel 3 Stainless steel 5 Fiberglass 8 RMP (SR) 11 Other (specify)

2 Brass	4 Galvanized steel	6 Concrete tile	9 ABS	12 None used (open hole)
---------	--------------------	-----------------	-------	--------------------------

SCREEN OR PERFORATION OPENINGS ARE: 5 Gauzed wrapped 8 Saw cut 11 None (open hole)

1 Continuous slot 3 Mill slot 6 Wire wrapped 9 Drilled holes

2 Louvered shutter 4 Key punched 7 Torch cut 10 Other (specify) ft.

SCREEN PERFORATED INTERVALS: From 95 ft to 105 ft From _____ ft to _____ ft

From ft. to ft., From ft. to ft.
From ft. to ft. From ft. to ft.

From ft. to ft., From ft. to ft.
From 22 ft to 44 ft From ft to ft

From 17 ft to 106 ft From 17 ft to 106 ft

6	GROUT MATERIAL:	1 Neat cement	2 Cement grout	<input checked="" type="radio"/> Bentonite	4 Other
---	-----------------	---------------	----------------	--	---------------

Grout Intervals: From 2 ft. to 22 ft. From 64 ft. to 67 ft. From _____ ft. to _____ ft.




2 Sewer lines 5 Cess pool 8 Sewage lagoon 12 Fertilizer storage 16 Other (specify below)

③ Watertight sewer lines 6 Seepage pit 9 Feedyard 13 Insecticide storage

Direction from well? *SE* How many feet? *75*

[illegible]

7 CONTRACTOR'S OR LANDOWNER'S CERTIFICATION: This water well was (1) constructed, (2) reconstructed, or (3) plugged under my jurisdiction and was completed on (mo/day/year) 4-13-00 and this record is true to the best of my knowledge and belief. Kansas

Water Well Contractor's Licence No. 447 This Water Well Record was completed on (mo/day/yr) 4-25-00

under the business name of Miller Drilling by (signature) E. Miller