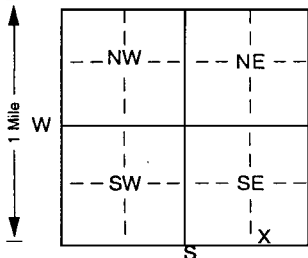


1 LOCATION OF WATER WELL:		Fraction	Section Number	Township Number	Range Number
County: Harvey		SW 1/4 SE 1/4 SE 1/4	31	T 23 S	R 2 E

Distance and direction from nearest town or city street address of well if located within city?

Approximately 3 1/4 miles west of Halstead

2 WATER WELL OWNER:		City of Wichita	Board of Agriculture, Division of Water Resources
RR#, St. Address, Box #		: 455 N. Main	Application Number:
City, State, ZIP Code		: Wichita, KS 67202	

3 LOCATE WELL'S LOCATION WITH AN "X" IN SECTION BOX:		4 DEPTH OF COMPLETED WELL 177 ft. ELEVATION: unknown	
		Depth(s) Groundwater Encountered 1 _____ ft. 2 _____ ft. 3 _____ ft.	
		WELL'S STATIC WATER LEVEL not checked ft. below land surface measured on mo/day/yr	
		Pump test data: Well water was not checked ft. after _____ hours pumping _____ gpm	
		Est. Yield unknown gpm: Well water was _____ ft. after _____ hours pumping _____ gpm	
		Bore Hole Diameter 6 in. to 190 ft., and _____ in. to _____ ft.	
WELL WATER TO BE USED AS:		5 Public water supply 8 Air conditioning 11 Injection well	
1 Domestic 3 Feedlot 6 Oil field water supply 9 Dewatering 12 Other (specify below)			
2 Irrigation 4 Industrial 7 Domestic (lawn & garden) 10 Monitoring well		Index Well	
Was a chemical/bacteriological sample submitted to Department? Yes _____ No <input checked="" type="checkbox"/>		If yes, mo/day/yr sample was submitted _____	
Water Well Disinfected? Yes _____ No <input checked="" type="checkbox"/>			

5 TYPE OF BLANK CASING USED:		5 Wrought iron 8 Concrete tile CASING JOINTS: Glued <input checked="" type="checkbox"/> Clamped	
1 Steel 3 RMP (SR)		Welded _____	
2 PVC 4 ABS		Threaded _____	
7 Fiberglass			
Blank casing diameter 2 in. to 155 ft., Dia _____ in. to _____ ft., Dia _____ in. to _____ ft.			
Casing height above land surface 24 in., weight .96 lbs./ft. Wall thickness or gauge No .218			
TYPE OF SCREEN OR PERFORATION MATERIAL:		7 PVC 10 Asbestos-cement	
1 Steel 3 Stainless steel 5 Fiberglass 8 RMP (SR) 11 Other (specify) _____			
2 Brass 4 Galvanized steel 6 Concrete tile 9 ABS 12 None used (open hole)			
SCREEN OR PERFORATION OPENINGS ARE:		5 Gauzed wrapped 8 Saw cut 11 None (open hole)	
1 Continuous slot 3 Mill slot 6 Wire wrapped 9 Drilled holes			
2 Louvered shutter 4 Key punched 7 Torch cut 10 Other (specify) _____ ft.			
SCREEN-PERFORATED INTERVALS: From 155 ft. to 175 ft., From _____ ft. to _____ ft.			
GRAVEL PACK INTERVALS: From 136 ft. to 177 ft., From _____ ft. to _____ ft.			

6 GROUT MATERIAL:		1 Neat cement 2 Cement grout 3 Bentonite 4 Other Sand	
Grout Intervals: From 0 ft. to 136 ft., From _____ ft. to _____ ft., From 177 ft. to 190 ft.			
What is the nearest source of possible contamination:		10 Livestock pens 14 Abandoned water well	
1 Septic tank 4 Lateral lines 7 Pit privy 11 Fuel storage 15 Oil well/Gas well			
2 Sewer lines 5 Cess pool 8 Sewage lagoon 12 Fertilizer storage 16 Other (specify below)			
3 Watertight sewer lines 6 Seepage pit 9 Feedyard 13 Insecticide storage None known			
Direction from well? _____		How many feet? _____	

FROM	TO	LITHOLOGIC LOG	FROM	TO	PLUGGING INTERVALS
0	3	Topsoil			
3	16	Clay, brown, sandy			
16	27	Sand and gravel, coarse, medium, fine, clean			
27	36	Clay, white and tan, hard			
36	79	Sand and gravel, coarse, medium, fine, clean			
79	83	Clay, gray, green, hard			
83	87	Sand, medium, fine			
87	92	Clay, gray, green, hard			
92	126	Sand and gravel, medium, fine, clay streaks			
126	131	Clay, tan and green, hard			
131	153	Clay, dark gray, hard			
153	176	Sand and gravel, medium, fine			
176	189	Clay, green and dark gray, hard			
189	190	Shale, black, hard			

7 CONTRACTOR'S OR LANDOWNER'S CERTIFICATION: This water well was (1) constructed (2) reconstructed or (3) plugged under my jurisdiction and was completed on (mo/day/year) 11-13-01 and this record is true to the best of my knowledge and belief. Kansas Water Contractor's License No 185 This Water Well Record was completed on (mo/day/yr) 11-28-01 under the business name of Clarke Well & Equipment, Inc. by (signature) _____	
---	--