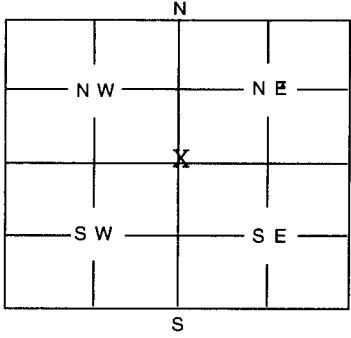


1	LOCATION OF WATER WELL: County: <b>HARVEY</b>	Fraction <b>NC-W. SIDE-E/2</b> $\frac{1}{4}$ $\frac{1}{4}$ $\frac{1}{4}$	Section	Number <b>4</b>	Township	Number <b>23 SOUTH</b>	Range	Number <b>2 WEST</b>																							
Distance and direction from nearest town or city street address of well if located within city? <b>FROM US HWY 50 &amp; HV CO. RD 801 INTERSECTION: 3.5 MILES NORTH &amp; 1.5 MILES WEST</b>																															
2	WATER WELL OWNER: <b>HARVEY GRANT FARMS INC., C/O DANIEL DYCK</b> RR #, St. Address, Box #: <b>512 A 1ST NAT'L CTR, #116</b> Board of Agriculture, Division of Water Resources City, State, ZIP Code : <b>HUTCHINSON, KS 67501</b> Application Number: <b>5865, 41294</b>																														
3	MARK WELL'S LOCATION WITH AN "X" IN SECTION BOX: <div style="text-align: center; margin-top: 10px;">  </div>		4 DEPTH OF WELL <u>107</u> ft WELL'S STATIC WATER LEVEL <u>35</u> ft WELL WAS USED AS: <table style="width:100%; border: none;"> <tr> <td>1 Domestic</td> <td>5 Public Water Supply</td> <td>9 Dewatering</td> </tr> <tr> <td>2 Irrigation</td> <td>6 Oil Field Water Supply</td> <td>10 Monitoring Well</td> </tr> <tr> <td><u>3 Feedlot</u></td> <td>7 Domestic (Lawn &amp; Garden)</td> <td>11 Injection Well</td> </tr> <tr> <td>4 Industrial</td> <td>8 Air Conditioning</td> <td>12 Other .....</td> </tr> </table> Was a chemical / bacteriological sample submitted to Department? Yes ..... No <u>X</u> ..... If yes, mo/day/yr sample was submitted ..... Water Well Disinfected: Yes ..... No <u>X</u> .....						1 Domestic	5 Public Water Supply	9 Dewatering	2 Irrigation	6 Oil Field Water Supply	10 Monitoring Well	<u>3 Feedlot</u>	7 Domestic (Lawn & Garden)	11 Injection Well	4 Industrial	8 Air Conditioning	12 Other .....											
1 Domestic	5 Public Water Supply	9 Dewatering																													
2 Irrigation	6 Oil Field Water Supply	10 Monitoring Well																													
<u>3 Feedlot</u>	7 Domestic (Lawn & Garden)	11 Injection Well																													
4 Industrial	8 Air Conditioning	12 Other .....																													
5	TYPE OF BLANK CASING USED: <table style="width:100%; border: none;"> <tr> <td>1 Steel</td> <td>3 RMP (SR)</td> <td>5 Wrought</td> <td>7 Fiberglass</td> <td>9 Other (Specify below)</td> </tr> <tr> <td><u>2 PVC</u></td> <td>4 ABS</td> <td>6 Asbestos-Cement</td> <td>8 Concrete Tile</td> <td></td> </tr> </table> Blank casing diameter <u>1.8</u> in. Was casing pulled? Yes ..... No <u>X</u> ..... If yes, how much ..... Casing height <del>above</del> below land surface <u>36</u> in.								1 Steel	3 RMP (SR)	5 Wrought	7 Fiberglass	9 Other (Specify below)	<u>2 PVC</u>	4 ABS	6 Asbestos-Cement	8 Concrete Tile														
1 Steel	3 RMP (SR)	5 Wrought	7 Fiberglass	9 Other (Specify below)																											
<u>2 PVC</u>	4 ABS	6 Asbestos-Cement	8 Concrete Tile																												
6	GROUT PLUG MATERIAL: 1 Neat cement <u>2 Cement grout</u> 3 Bentonite   4 Other ..... Grout Plug Intervals: From <u>35</u> ft. to <u>3</u> ft., From ..... ft. to ..... ft., From ..... to ..... What is the nearest source of possible contamination: <table style="width:100%; border: none;"> <tr> <td>1 Septic tank</td> <td>6 Seepage pit</td> <td>11 Fuel storage</td> <td>16 Other (specify below)</td> </tr> <tr> <td>2 Sewer lines</td> <td>7 Pit privy</td> <td>12 Fertilizer storage</td> <td></td> </tr> <tr> <td>3 Watertight sewer lines</td> <td>8 Sewage lagoon</td> <td>13 Insecticide storage</td> <td></td> </tr> <tr> <td>4 Lateral lines</td> <td>9 Feedyard</td> <td>14 Abandoned water well</td> <td></td> </tr> <tr> <td>5 Cess Pool</td> <td>10 Livestock pens</td> <td>15 Oil well/Gas well</td> <td></td> </tr> </table> Direction from well? <u>NORTH</u> How many feet? <u>APPROX. 30</u>								1 Septic tank	6 Seepage pit	11 Fuel storage	16 Other (specify below)	2 Sewer lines	7 Pit privy	12 Fertilizer storage		3 Watertight sewer lines	8 Sewage lagoon	13 Insecticide storage		4 Lateral lines	9 Feedyard	14 Abandoned water well		5 Cess Pool	10 Livestock pens	15 Oil well/Gas well				
1 Septic tank	6 Seepage pit	11 Fuel storage	16 Other (specify below)																												
2 Sewer lines	7 Pit privy	12 Fertilizer storage																													
3 Watertight sewer lines	8 Sewage lagoon	13 Insecticide storage																													
4 Lateral lines	9 Feedyard	14 Abandoned water well																													
5 Cess Pool	10 Livestock pens	15 Oil well/Gas well																													
<table border="1" style="width:100%; border-collapse: collapse;"> <thead> <tr> <th style="width:10%;">FROM</th> <th style="width:10%;">TO</th> <th style="width:80%;">PLUGGING MATERIALS</th> </tr> </thead> <tbody> <tr> <td>107</td> <td>35</td> <td>COARSE SAND</td> </tr> <tr> <td>35</td> <td>3</td> <td>CEMENT GROUT</td> </tr> <tr> <td>3</td> <td>0</td> <td>TOPSOIL</td> </tr> <tr><td> </td><td> </td><td> </td></tr> <tr><td> </td><td> </td><td> </td></tr> <tr><td> </td><td> </td><td> </td></tr> <tr><td> </td><td> </td><td> </td></tr> </tbody> </table>			FROM	TO	PLUGGING MATERIALS	107	35	COARSE SAND	35	3	CEMENT GROUT	3	0	TOPSOIL													SAND AND GROUT PORTION OF PLUGGING WITNESSED BY TIM BOESE, EQUUS BEDS GMD2  <div style="text-align: right; font-size: 1.5em; font-weight: bold;">RECEIVED</div> <div style="text-align: right;">AUG 16 2002</div> <div style="text-align: right; font-size: 0.8em;">EQUUS BEDS GROUNDWATER MANAGEMENT DISTRICT NO. 2</div>				
FROM	TO	PLUGGING MATERIALS																													
107	35	COARSE SAND																													
35	3	CEMENT GROUT																													
3	0	TOPSOIL																													
7	CONTRACTOR'S OR LANDOWNER'S CERTIFICATION: This water well was plugged under my jurisdiction and was completed on (mo/day/year) <u>8-1-2002</u> and this record is true to the best of my knowledge and belief. Kansas Water Well Contractor's License No. <u>NA</u> This Water Well Record was completed on (mo/day/year) ..... by (signature) <u>Edward A. Koehn</u> under the business name of <u>NA</u> <b>EDWARD A. KOEHN, TENANT</b>																														

INSTRUCTIONS: Use typewriter or ball point pen. Please press firmly and print clearly. Please fill in blanks, underline or circle the correct answers. Send top three copies to Kansas Department of Health and Environment, Bureau of Water, Topeka, Kansas 66620-0001. Telephone: 785/296-3565. Send one to Water Well Owner and retain one for your records.