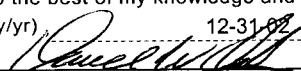


1 LOCATION OF WATER WELL:		Fraction		Section Number		Township Number		Range Number	
County: Harvey		NE 1/4 SE 1/4 SW 1/4		8		T 23 S		R 2 E W	
Distance and direction from nearest town or city street address of well if located within city? Approximately 6 miles east and 2 1/4 miles north of Burrton	
2 WATER WELL OWNER: City of Wichita RR#, St. Address, Box # : 455 N. Main City, State, ZIP Code : Wichita, KS 67202 Board of Agriculture, Division of Water Resources Application Number:	
3 LOCATE WELL'S LOCATION WITH AN "X" IN SECTION BOX:			4 DEPTH OF COMPLETED WELL 162 ft. ELEVATION: unknown	
N 1 Mile W E S X			Depth(s) Groundwater Encountered 1 ft. 2 ft. 3 ft. ft.	
			WELL'S STATIC WATER LEVEL 18.49 ft. below land surface measured on mo/day/yr	
			Pump test data: Well water was not checked ft. after hours pumping gpm	
			Est. Yield unknown gpm: Well water was ft. after hours pumping gpm	
			Bore Hole Diameter 6 in. to 175 ft., and in. to ft.	
			WELL WATER TO BE USED AS: 5 Public water supply 8 Air conditioning 11 Injection well 1 Domestic 3 Feedlot 6 Oil field water supply 9 Dewatering 12 Other (specify below) 2 Irrigation 4 Industrial 7 Domestic (lawn & garden) 10 Monitoring well	
			Was a chemical/bacteriological sample submitted to Department? Yes No ☒ If yes, mo/day/yr sample was submitted Water Well Disinfected? Yes No ☒	
5 TYPE OF BLANK CASING USED:	
1 Steel 3 RMP (SR) 5 Wrought iron 8 Concrete tile			CASING JOINTS: Glued Clamped	
2 PVC 4 ABS 6 Asbestos-Cement 9 Other (specify below)			Welded	
			Threaded ☒	
Blank casing diameter 2 in. to 100 ft., Dia			in. to ft., Dia in. to ft.	
Casing height above land surface 24 in., weight .70			lbs./ft. Wall thickness or gauge No .154	
TYPE OF SCREEN OR PERFORATION MATERIAL:	
1 Steel 3 Stainless steel 5 Fiberglass 8 RMP (SR)			10 Asbestos-cement	
2 Brass 4 Galvanized steel 6 Concrete tile 9 ABS			11 Other (specify)	
			12 None used (open hole)	
SCREEN OR PERFORATION OPENINGS ARE:	
1 Continuous slot 3 Mill slot 5 Gauzed wrapped 8 Saw cut 11 None (open hole)	
2 Louvered shutter 4 Key punched 6 Wire wrapped 9 Drilled holes	
SCREEN-PERFORATED INTERVALS: From 100 ft. to 160 ft., From ft. to ft.	
GRAVEL PACK INTERVALS: From 58 ft. to 175 ft., From ft. to ft.	
6 GROUT MATERIAL: 1 Neat cement 2 Cement grout 3 Bentonite 4 Other Bentonite Holeplug	
Grout Intervals: From ft. to ft., From ft. to ft., From 0 ft. to 58 ft.	
What is the nearest source of possible contamination:	
1 Septic tank 4 Lateral lines 7 Pit privy			10 Livestock pens 14 Abandoned water well	
2 Sewer lines 5 Cess pool 8 Sewage lagoon			11 Fuel storage 15 Oil well/Gas well	
3 Watertight sewer lines 6 Seepage pit 9 Feedyard			12 Fertilizer storage 16 Other (specify below)	
			13 Insecticide storage None known	
Direction from well? How many feet?	
<table border="1" style="width:100%; border-collapse: collapse;"><thead><tr><th>FROM</th><th>TO</th><th>LITHOLOGIC LOG</th><th>FROM</th><th>TO</th><th>PLUGGING INTERVALS</th></tr></thead><tbody><tr><td>0</td><td>5</td><td>Topsoil</td><td>129</td><td>131</td><td>Clay, tan</td></tr><tr><td>5</td><td>16</td><td>Clay, dark gray and brown, sandy, hard</td><td>131</td><td>138</td><td>Sand, coarse to fine with thin clay streak, green</td></tr><tr><td>16</td><td>23</td><td>Sand, coarse to fine, loose</td><td>138</td><td>142</td><td>Clay, tan and white</td></tr><tr><td>23</td><td>29</td><td>Clay, black, soft, sandy</td><td>142</td><td>158</td><td>Sand, coarse to fine with thin clay straks and gravel, fine, loose, clean</td></tr><tr><td>29</td><td>39</td><td>Sand, coarse to fine, gray</td><td></td><td></td><td></td></tr><tr><td>39</td><td>55</td><td>Clay, white, soft, sandy</td><td>158</td><td>160</td><td>Clay, white with sand streaks</td></tr><tr><td>55</td><td>58</td><td>Clay, brown</td><td>160</td><td>162</td><td>Sand, coarse to fine with gravel, fine</td></tr><tr><td>58</td><td>63</td><td>Sand, coarse to fine with gravel, fine, loose, clean</td><td>162</td><td>169</td><td>Shale, green, weathered</td></tr><tr><td>63</td><td>69</td><td>Clay, gray and white, hard</td><td>169</td><td>175</td><td>Shale, black</td></tr><tr><td>69</td><td>79</td><td>Sand, coarse to fine with clay streaks</td><td></td><td></td><td></td></tr><tr><td>79</td><td>83</td><td>Clay, white</td><td></td><td></td><td></td></tr><tr><td>83</td><td>117</td><td>Sand, coarse to fine with gravel, fine, loose, clean</td><td></td><td></td><td></td></tr><tr><td>117</td><td>124</td><td>Clay, white, hard</td><td></td><td></td><td></td></tr><tr><td>124</td><td>129</td><td>Sand, coarse to fine with gravel, fine, thin clay streaks</td><td></td><td></td><td></td></tr>
7 CONTRACTOR'S OR LANDOWNER'S CERTIFICATION: This water well was (1) constructed , (2) reconstructed, or (3) plugged under my jurisdiction and was completed on (mo/day/year) 12-17-02 and this record is true to the best of my knowledge and belief. Kansas Water Well Contractor's License No 185 This Water Well Record was completed on (mo/day/yr) 12-31-02 under the business name of Clarke Well & Equipment, Inc. by (signature) 	
INSTRUCTIONS: Use typewriter or ball point pen. PLEASE PRESS FIRMLY and PRINT clearly. Please fill in blanks, underline or circle the correct answers. Send top three copies to Kansas Department of Health and Environment, Bureau of Water, Topeka, Kansas 66620-0001. Telephone 785-296-5524. Send one to WATER WELL OWNER and retain one for your records. Fee of \$5.00 for each constructed well.	