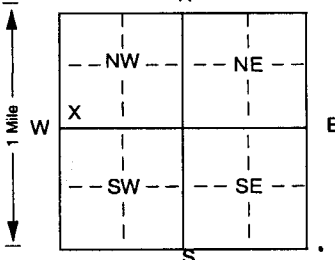


1 LOCATION OF WATER WELL:		Fraction		Section Number		Township Number		Range Number	
County: Harvey		SW 1/4 SW 1/4 NW 1/4		8		T 23 S		R 2 E (W)	

Distance and direction from nearest town or city street address of well if located within city?

Approximately 5 1/2 miles east and 2 1/2 miles north of Burrton

2 WATER WELL OWNER:		City of Wichita		Board of Agriculture, Division of Water Resources	
RR#, St. Address, Box #		: 455 N. Main		Application Number:	
City, State, ZIP Code		Wichita, KS 67202			

3 LOCATE WELL'S LOCATION WITH AN "X" IN SECTION BOX:		4 DEPTH OF COMPLETED WELL 140 ft. ELEVATION: unknown	
		Depth(s) Groundwater Encountered 1 ft. 2 ft. 3 ft.	
		WELL'S STATIC WATER LEVEL not checked ft. below land surface measured on mo/day/yr	
		Pump test data: Well water was not checked ft. after hours pumping gpm	
		Est. Yield unknown gpm: Well water was ft. after hours pumping gpm	
		Bore Hole Diameter 6 in. to 150 ft., and in. to ft.	
WELL WATER TO BE USED AS:		5 Public water supply 8 Air conditioning 11 Injection well	
1 Domestic 3 Feedlot 6 Oil field water supply 9 Dewatering 12 Other (specify below)			
2 Irrigation 4 Industrial 7 Domestic (lawn & garden) 10 Monitoring well			
Was a chemical/bacteriological sample submitted to Department? Yes No ☒		If yes, mo/day/yr sample was submitted	
Water Well Disinfected? Yes No ☒			

5 TYPE OF BLANK CASING USED:		5 Wrought iron 8 Concrete tile		CASING JOINTS: Glued Clamped	
1 Steel 3 RMP (SR)		6 Asbestos-Cement 9 Other (specify below)		Welded	
2 PVC 4 ABS		7 Fiberglass		Threaded ☒	
Blank casing diameter 2 in. to 98 ft., Dia		in. to ft., Dia		in. to ft.	
Casing height above land surface 24 in., weight .70 lbs./ft. Wall thickness or gauge No .154					
TYPE OF SCREEN OR PERFORATION MATERIAL:		7 PVC 10 Asbestos-cement			
1 Steel 3 Stainless steel 5 Fiberglass 8 RMP (SR) 11 Other (specify)					
2 Brass 4 Galvanized steel 6 Concrete tile 9 ABS 12 None used (open hole)					
SCREEN OR PERFORATION OPENINGS ARE:		5 Gauzed wrapped 8 Saw cut 11 None (open hole)			
1 Continuous slot 3 Mill slot 6 Wire wrapped 9 Drilled holes					
2 Louvered shutter 4 Key punched 7 Torch cut 10 Other (specify)					
SCREEN-PERFORATED INTERVALS: From 98 ft. to 138 ft., From ft. to ft.					
GRAVEL PACK INTERVALS: From 55 ft. to 150 ft., From ft. to ft.					

6 GROUT MATERIAL:		1 Neat cement 2 Cement grout 3 Bentonite		4 Other Bentonite Holeplug	
Grout Intervals: From ft. to ft., From ft. to ft., From 0 ft. to 55 ft.					
What is the nearest source of possible contamination:		10 Livestock pens 14 Abandoned water well			
1 Septic tank 4 Lateral lines 7 Pit privy 11 Fuel storage 15 Oil well/Gas well					
2 Sewer lines 5 Cess pool 8 Sewage lagoon 12 Fertilizer storage 16 Other (specify below)					
3 Watertight sewer lines 6 Seepage pit 9 Feedyard 13 Insecticide storage None known					
Direction from well?		How many feet?			

FROM	TO	LITHOLOGIC LOG	FROM	TO	PLUGGING INTERVALS
0	7	Topsoil	118	122	Clay, tan and white
7	14	Clay, dark brown	122	137	Sand, coarse to very fine with gravel, fine to medium, clay streak, tan at 127' - 129'
14	21	Clay, gray			
21	27	Clay, gray, sandy, soft	137	144	Shale, green, limy, hard
27	30	Clay, green, sand streaks	144	150	Shale, black, hard
30	39	Sand, coarse to very fine with gravel, fine			
39	54	Clay, green with sand streaks			
54	80	Sand, coarse to very fine with clay streaks and gravel, fine			
80	91	Clay, white and tan			
91	104	Sand, coarse to very fine with gravel, fine, clay streaks			
104	112	Clay, tan and white			
112	118	Sand, coarse to very fine with gravel, fine to medium			

7 CONTRACTOR'S OR LANDOWNER'S CERTIFICATION: This water well was (1) constructed (2) reconstructed or (3) plugged under my jurisdiction and was completed on (mo/day/year) 12-19-02 and this record is true to the best of my knowledge and belief. Kansas Water Well Contractor's License No 185 This Water Well Record was completed on (mo/day/yr) 12-31-02 under the business name of Clarke Well & Equipment, Inc. by (signature) [Signature]	
--	--