

1 LOCATION OF WATER WELL:	Fraction	Section Number	Township Number	Range Number
County: <u>Harvey</u>	$\frac{1}{4}$ <u>N</u> $\frac{1}{4}$ <u>SW</u> $\frac{1}{4}$	<u>14</u>	T <u>23</u> S	R <u>2</u> E <u>W</u>

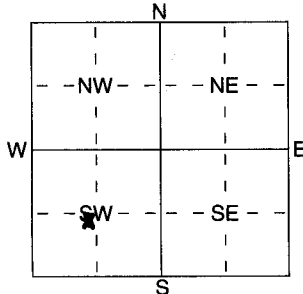
Distance and direction from nearest town or city street address of well if located within city?

From Halstead, KS: 3 miles North2 WATER WELL OWNER: Harvey Grant Farms - Dan PrykRR#, St. Address, Box # : 1 North Main Ste 512 ACity, State, ZIP Code : Hutchinson KS 67501

Board of Agriculture, Division of Water Resources

Application Number: 45,5253 LOCATE WELL'S LOCATION WITH 4 DEPTH OF COMPLETED WELL 54' ft. ELEVATION:

AN "X" IN SECTION BOX:

Depth(s) Groundwater Encountered 1 25' ft. 2 ft. 3 ft.
WELL'S STATIC WATER LEVEL 25' ft. below land surface measured on mo/day/yr 10-31-03Pump test data: Well water was 42 ft. after 1 hours pumping 200 gpm
Est. Yield 150 gpm: Well water was ft. after hours pumping gpm

WELL WATER TO BE USED AS: 5 Public water supply 8 Air conditioning 11 Injection well

1 Domestic 3 Feedlot 6 Oil field water supply 9 Dewatering 12 Other (Specify below)

2 Irrigation 4 Industrial 7 Domestic (lawn & garden) 10 Monitoring well

Was a chemical/bacteriological sample submitted to Department? Yes No X; If yes, mo/day/yr sample was submitted
Water Well Disinfected? Yes X No5 TYPE OF BLANK CASING USED: 5 Wrought iron 8 Concrete tile CASING JOINTS: Glued X Clamped

1 Steel 3 RMP (SR) 6 Asbestos-Cement 9 Other (specify below) Welded

PVC 4 ABS 7 Fiberglass ThreadedBlank casing diameter 16 in. to 40 ft., Dia in. to ft., Dia in. to ft.Casing height above land surface 12 in., weight 16 lbs./ft. Wall thickness or gauge No. 1/2"

TYPE OF SCREEN OR PERFORATION MATERIAL:

1 Steel 3 Stainless Steel 5 Fiberglass 8 RMP (SR) 10 Asbestos-Cement

2 Brass 4 Galvanized Steel 6 Concrete tile 9 ABS 11 Other (Specify)

12 None used (open hole)

SCREEN OR PERFORATION OPENINGS ARE:

1 Continuous slot 2 Mill slot 5 Gauzed wrapped 8 Saw cut 11 None (open hole)

2 Louvered shutter 4 Key punched 6 Wire wrapped 9 Drilled holes

7 Torch cut 10 Other (specify)

SCREEN-PERFORATED INTERVALS: From 40 ft. to 54 ft., From ft. to ft.GRAVEL PACK INTERVALS: From 20 ft. to 54 ft., From ft. to ft.

From ft. to ft., From ft. to ft.

From ft. to ft., From ft. to ft.

From ft. to ft., From ft. to ft.

6 GROUT MATERIAL: 1 Neat cement 2 Cement grout 3 Bentonite 4 Other

Grout Intervals: From 3 ft. to 20 ft., From ft. to ft., From ft. to ft.

What is the nearest source of possible contamination:

1 Septic tank 4 Lateral lines 7 Pit privy 10 Livestock pens 14 Abandoned water well

2 Sewer lines 5 Cess pool 8 Sewage lagoon 11 Fuel storage 15 Oil well/Gas well

3 Watertight sewer lines 6 Seepage pit 9 Feedyard 12 Fertilizer storage 16 Other (specify below)

13 Insecticide storage Irrigation WellDirection from well? 250 South How many feet? 250

FROM TO LITHOLOGIC LOG FROM TO PLUGGING INTERVALS

0 2 Topsoil

2 40 Clay

40 52 Small Gravel

52 54 Clay

7 CONTRACTOR'S OR LANDOWNER'S CERTIFICATION: This water well was (1) constructed, (2) reconstructed, or (3) plugged under my jurisdiction and was completed on (mo/day/yr) 10-31-03 and this record is true to the best of my knowledge and belief. Kansas Water Well Contractor's Licence No. 238 This Water Well Record was completed on (mo/day/yr) 11-17-03 under the business name of Wendy's Irrigation by (signature) Wendy's Irrigation

INSTRUCTIONS: Use typewriter or ball point pen. PLEASE PRESS FIRMLY and PRINT clearly. Please fill in blanks, underline or circle the correct answers. Send top three copies to Kansas Department of Health and Environment, Bureau of Water, Geology Section, 1000 SW Jackson St., Suite 420, Topeka, Kansas 66612-1367. Telephone 785-296-5522. Send one to WATER WELL OWNER and retain one for your records. Fee of \$5.00 for each constructed well.