

1 LOCATION OF WATER WELL:	Fraction	Section Number	Township Number	Range Number
County: <u>Harvey</u>	<u>NE 1/4 West Edge SW 1/4</u>	<u>14</u>	T <u>23</u> S	R <u>2</u> E <u>W</u>

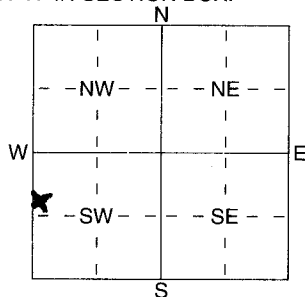
Distance and direction from nearest town or city street address of well if located within city?

From Halstead, KS: 3 1/4 miles North2 WATER WELL OWNER: Dan Dyke, Harvey Grant FarmsRR#, St. Address, Box #: 1 North Main St. 512ACity, State, ZIP Code: Hatchersburg, KS 67501

Board of Agriculture, Division of Water Resources

Application Number: 45,5253 LOCATE WELL'S LOCATION WITH 4 DEPTH OF COMPLETED WELL 60 ft. ELEVATION: 60

AN "X" IN SECTION BOX:


WELL WATER TO BE USED AS: 5 Public water supply 8 Air conditioning 11 Injection well

1 Domestic 3 Feedlot 6 Oil field water supply 9 Dewatering 12 Other (Specify below)

2 Irrigation 4 Industrial 7 Domestic (lawn & garden) 10 Monitoring wellWas a chemical/bacteriological sample submitted to Department? Yes X No X; If yes, mo/day/yr sample was submitted Water Well Disinfected? Yes X No X5 TYPE OF BLANK CASING USED: 5 Wrought iron 8 Concrete tile CASING JOINTS: Glued X Clamped

1 Steel 3 RMP (SR) 6 Asbestos-Cement 9 Other (specify below) Welded

2 PVC 4 ABS 7 Fiberglass ThreadedBlank casing diameter 2 in. to 50 ft. Dia 2 in. to 50 ft. Dia 2 in. to 50 ft.Casing height above land surface 24 in., weight 2 lbs./ft. Wall thickness or gauge No. 5/8 40

TYPE OF SCREEN OR PERFORATION MATERIAL:

1 Steel 3 Stainless Steel 5 Fiberglass 2 PVC 10 Asbestos-Cement

2 Brass 4 Galvanized Steel 6 Concrete tile 9 ABS 11 Other (Specify)

SCREEN OR PERFORATION OPENINGS ARE: 5 Gauzed wrapped 2 Saw cut 11 None (open hole)

1 Continuous slot 3 Mill slot 6 Wire wrapped 9 Drilled holes

2 Louvered shutter 4 Key punched 7 Torch cut 10 Other (specify) 2 ft.SCREEN-PERFORATED INTERVALS: From 50 ft. to 60 ft. From 50 ft. to 60 ft.GRAVEL PACK INTERVALS: From 45 ft. to 60 ft. From 45 ft. to 60 ft.7 CONTRACTOR'S OR LANDOWNER'S CERTIFICATION: This water well was 4 constructed, (2) reconstructed, or (3) plugged under my jurisdiction and was completed on (mo/day/year) 3-30-04 and this record is true to the best of my knowledge and belief. KansasWater Well Contractor's Licence No 238 This Water Well Record was completed on (mo/day/yr) 4-1-04under the business name of Wendner Irrigation by (signature) Wendner

INSTRUCTIONS: Use typewriter or ball point pen. PLEASE PRESS FIRMLY and PRINT clearly. Please fill in blanks, underline the correct answers. Send top three copies to Kansas Department of Health and Environment, Bureau of Water, Geology Section, 1000 SW Jackson St., Suite 420, Topeka, Kansas 66612-1367. Telephone 785-296-5522. Send one to WATER WELL OWNER and retain one for your records. Fee of \$5.00 for each constructed well.