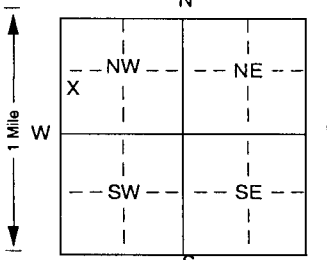


1 LOCATION OF WATER WELL:		Fraction	Section Number		Township Number			Range Number		
County: Harvey		NW 1/4 SW 1/4 NW 1/4	8		T 23 S			R 2 E (W)		

Distance and direction from nearest town or city street address of well if located within city?

Approximately 3 miles west and 4 3/4 miles north of Halstead

2 WATER WELL OWNER:		City of Wichita	Board of Agriculture, Division of Water Resources Application Number:
RR#, St. Address, Box #		:455 N. Main	
City, State, ZIP Code		Wichita, KS 67202	

3 LOCATE WELL'S LOCATION WITH AN "X" IN SECTION BOX:		4 DEPTH OF COMPLETED WELL 127 ft. ELEVATION: unknown	
		Depth(s) Groundwater Encountered 1 ft. 2 ft. 3 ft. ft.	
		WELL'S STATIC WATER LEVEL 10.11 ft. below land surface measured on mo/day/yr 5-18-04	
		Pump test data: Well water was not checked ft. after hours pumping gpm	
		Est. Yield unknown gpm: Well water was ft. after hours pumping gpm	
		Bore Hole Diameter 6 in. to 143 ft., and in. to ft.	
WELL WATER TO BE USED AS:		5 Public water supply 8 Air conditioning 11 Injection well	
1 Domestic 3 Feedlot 6 Oil field water supply 9 Dewatering 12 Other (specify below)		2 Irrigation 4 Industrial 7 Domestic (lawn & garden) 10 Monitoring well Observation Well	
Was a chemical/bacteriological sample submitted to Department? Yes No <input checked="" type="checkbox"/> If yes, mo/day/yr sample was submitted			
Water Well Disinfected? Yes No <input checked="" type="checkbox"/>			

5 TYPE OF BLANK CASING USED:		5 Wrought iron 8 Concrete tile CASING JOINTS: Glued <input checked="" type="checkbox"/> Clamped	
1 Steel 3 RMP (SR) 6 Asbestos-Cement 9 Other (specify below) Welded		Threaded	
(2) PVC 4 ABS 7 Fiberglass			
Blank casing diameter 2 in. to 85 ft., Dia in. to ft., Dia in. to ft.			
Casing height above land surface 24 in., weight .70 lbs./ft. Wall thickness or gauge No .154			
TYPE OF SCREEN OR PERFORATION MATERIAL:		(7) PVC 10 Asbestos-cement	
1 Steel 3 Stainless steel 5 Fiberglass 8 RMP (SR) 11 Other (specify)		12 None used (open hole)	
2 Brass 4 Galvanized steel 6 Concrete tile 9 ABS			
SCREEN OR PERFORATION OPENINGS ARE:		5 Gauzed wrapped 8 Saw cut 11 None (open hole)	
1 Continuous slot (3) Mill slot 6 Wire wrapped 9 Drilled holes		10 Other (specify) ft.	
2 Louvered shutter 4 Key punched 7 Torch cut			
SCREEN-PERFORATED INTERVALS: From 85 ft. to 125 ft., From ft. to ft.			
GRAVEL PACK INTERVALS: From 75 ft. to 143 ft., From ft. to ft.			

6 GROUT MATERIAL:		1 Neat cement 2 Cement grout 3 Bentonite 4 Other Bentonite Holeplug	
Grout Intervals: From ft. to ft., From ft. to ft., From 0 ft. to 75 ft.			
What is the nearest source of possible contamination:		10 Livestock pens 14 Abandoned water well	
1 Septic tank 4 Lateral lines 7 Pit privy 11 Fuel storage 15 Oil well/Gas well		16 Other (specify below)	
2 Sewer lines 5 Cess pool 8 Sewage lagoon 12 Fertilizer storage		None known	
3 Watertight sewer lines 6 Seepage pit 9 Feedyard 13 Insecticide storage			
Direction from well?		How many feet?	

FROM	TO	LITHOLOGIC LOG	FROM	TO	PLUGGING INTERVALS
0	5	Topsoil			
5	14	Clay, brown			
14	22	Clay, gray			
22	38	Clay, dark gray, soft			
38	41	Sand and gravel, medium to fine			
41	60	Clay, green with gravel streaks			
60	76	Sand and gravel, medium to fine with clay streaks			
76	79	Clay, tan			
79	136	Sand and gravel, medium to fine with clay streaks			
136	143	Shale, green with lime streaks			

7 CONTRACTOR'S OR LANDOWNER'S CERTIFICATION: This water well was (1) constructed (2) reconstructed or (3) plugged under my jurisdiction and was completed on (mo/day/year) 5-18-04 and this record is true to the best of my knowledge and belief. Kansas Water Well Contractor's License No 185 This Water Well Record was completed on (mo/day/yr) 5-21-04 under the business name of Clarke Well & Equipment, Inc. by (signature)	
--	--