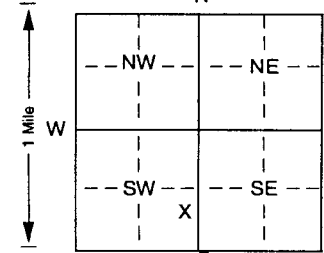


1 LOCATION OF WATER WELL:		WATER WELL RECORD Form WWS-9		KSA 028-1212 ID NO.		Section Number		Township Number		Range Number	
County: Harvey		NE 1/4 SE 1/4 SW 1/4		8		T 23 S		R 2 E		W	
Distance and direction from nearest town or city street address of well if located within city? Approximately 2 1/2 miles west and 4 1/4 miles north of Halstead											
2 WATER WELL OWNER: City of Wichita RR#, St. Address, Box # : 455 N. Main City, State, ZIP Code : Wichita, KS 67202 Board of Agriculture, Division of Water Resources Application Number:											
3 LOCATE WELL'S LOCATION WITH AN "X" IN SECTION BOX:				4 DEPTH OF COMPLETED WELL 41 ft. ELEVATION: unknown							
				Depth(s) Groundwater Encountered 1 ft. 2 ft. 3 ft.							
				WELL'S STATIC WATER LEVEL 22.11 ft. below land surface measured on mo/day/yr 3-15-05							
				Pump test data: Well water was not checked ft. after hours pumping gpm							
				Est. Yield unknown gpm: Well water was ft. after hours pumping gpm							
				Bore Hole Diameter 6 in. to 40 ft., and in. to ft.							
WELL WATER TO BE USED AS: 5 Public water supply 8 Air conditioning 11 Injection well 1 Domestic 3 Feedlot 6 Oil field water supply 9 Dewatering 12 Other (specify below) 2 Irrigation 4 Industrial 7 Domestic (lawn & garden) 10 Monitoring well Observation Well											
Was a chemical/bacteriological sample submitted to Department? Yes No <input checked="" type="checkbox"/> If yes, mo/day/yr sample was submitted Water Well Disinfected? Yes No <input checked="" type="checkbox"/>											
5 TYPE OF BLANK CASING USED: 1 Steel 3 RMP (SR) 5 Wrought iron 8 Concrete tile CASING JOINTS: Glued <input checked="" type="checkbox"/> Clamped 2 PVC 4 ABS 6 Asbestos-Cement 9 Other (specify below) Welded 7 Fiberglass Threaded Blank casing diameter 2 in. to 19 ft., Dia in. to ft., Dia in. to ft. Casing height above land surface 24 in., weight .70 lbs./ft. Wall thickness or gauge No .154											
TYPE OF SCREEN OR PERFORATION MATERIAL: 1 Steel 3 Stainless steel 5 Fiberglass 8 RMP (SR) 10 Asbestos-cement 2 Brass 4 Galvanized steel 6 Concrete tile 9 ABS 11 Other (specify) 12 None used (open hole)											
SCREEN OR PERFORATION OPENINGS ARE: 1 Continuous slot 3 Mill slot 5 Gauzed wrapped 8 Saw cut 11 None (open hole) 2 Louvered shutter 4 Key punched 6 Wire wrapped 9 Drilled holes 7 Torch cut 10 Other (specify) ft.											
SCREEN-PERFORATED INTERVALS: From 19 ft. to 39 ft., From ft. to ft. From ft. to ft., From ft. to ft. GRAVEL PACK INTERVALS: From 10 ft. to 41 ft., From ft. to ft. From ft. to ft., From ft. to ft.											
6 GROUT MATERIAL: 1 Neat cement 2 Cement grout 3 Bentonite 4 Other Bentonite Holeplug Grout Intervals: From ft. to ft., From ft. to ft., From 0 ft. to 10 ft. What is the nearest source of possible contamination: 1 Septic tank 4 Lateral lines 7 Pit privy 10 Livestock pens 14 Abandoned water well 2 Sewer lines 5 Cess pool 8 Sewage lagoon 11 Fuel storage 15 Oil well/Gas well 3 Watertight sewer lines 6 Seepage pit 9 Feedyard 12 Fertilizer storage 16 Other (specify below) 13 Insecticide storage None known Direction from well? How many feet?											
FROM TO LITHOLOGIC LOG FROM TO PLUGGING INTERVALS											
0 5 Topsoil											
5 7 Clay, dark brown, hard											
7 16 Clay, light brown, hard											
16 27 Clay, gray, hard											
27 37 Sand, coarse to fine, loose with gravel, fine, clay streaks, gray											
37 39 Sand and gravel, medium to fine, loose, gray											
39 40 Clay, blue-green, hard											
7 CONTRACTOR'S OR LANDOWNER'S CERTIFICATION: This water well was (1) constructed (2) reconstructed or (3) plugged under my jurisdiction and was completed on (mo/day/year) 3-15-05 and this record is true to the best of my knowledge and belief. Kansas Water Well Contractor's License No 185 This Water Well Record was completed on (mo/day/yr) 3-22-05 under the business name of Clarke Well & Equipment, Inc. by (signature) [Signature]											
INSTRUCTIONS: Use typewriter or ball point pen. PLEASE PRESS FIRMLY and PRINT clearly. Please fill in blanks, underline or circle the correct answers. Send top three copies to Kansas Department of Health and Environment, Bureau of Water, Topeka, Kansas 66620-0001. Telephone 785-296-5524. Send one to WATER WELL OWNER and retain one for your records. Fee of \$5.00 for each constructed well.											