ě.		W	ATER WELL REG	CORD	Form WW	/C-5	KSA 82a	-1212 II	D No.			
1 LOCAT		ATER WELL:	Fraction 1/4				Se	ction Numb			Range Nu	mber
			wn or city street									
2 WATER	R WELL OW	NER: R. Wir	ngton Nov	Ham	. <	Ja F	o Oail		e see atto	ichea	map	1
RR#, St. Ad City, State,	ddress, Box	# : 4515	Kansas sas City				e lain	wwy (			Division of Water I	Resources
		CATION WITH	4 DEPTH OF	COMPLET	TED WELL	/5 2	7	ft. ELE	EVATION:			
	N SECTION N		Depth(s) Grou WELL'S STAT	ndwater E C WATER mp test d	ncountere R LEVEL ata: Well	d 1. <b>21.5</b> water v	ft. bel was	ow land su	ft. 2 rface measured on m ft. after ft. after	ft. 3 o/day/yr hours p	umping	gpm
w	-NW	- NE        E	WELL WATER 1 Domestic 2 Irrigation	TO BE U		5 Pu 6 Oi	ıblic water I field wate	supply r supply	8 Air conditionin 9 Dewatering n) 10 Monitoring we	g 11 li 12 (	njection well Other (Specify bel	low)
	-SW	ical/bacteriological sample submitted to Department? Yes No; If yes, mo/day/yrs sample was sub- Water Well Disinfected? Yes No										
1_Stee	TYPE OF BLANK CASING USED:  1 Steel 3 RMP (SR) 2 PVC 4 ABS					5 Wrought iron 6 Asbestos-Cement 7 Fiberglass			low)	Weld	d Clampe	
			in. to			)ia			ft., Di		adedin. to	
Casing height above land surface									lbs./ft. Wall thickn		ge No <b></b>	
1 Steel 3 Stainless Steel 2 Brass 4 Galvanized Steel					5 Fiberglass 6 Concrete tile			MP (SR) SS	11 Oth		)	
		RATION OPENII	NGS ARE:	o come	5		d wrapped		8 Saw cut	110 0000 (0)	11 None (open	hole)
1 Continuous slot 2 Louvered shutter  3 Mill slot 4 Key punched					6 Wire wrapped 7 Torch cut							
SCREEN-F	PERFORAT	ED INTERVALS	: From	2	ft. to	o2	ר	ft., Fr	om	ft. to		ft.
C	GRAVEL PA	CK INTERVALS	6: From	0	ft. to	o <b>.7</b>	<b>.</b>	ft., Fr	om om	ft. to		ft.
6 GROU	T MATERIA	AL: 1 Nea	at cement	2 Ce	ment grout	t	(3)Ben	tonite	4 Other			
Grout Inter	vals: Fro	m2	ft. to <b>/.Q</b> .				_		ft., From		ft. to	ft.
		urce of possible							estock pens		Abandoned water	well
1 Septic tank 4 Lateral lines					7 Pit privy			_	el storage	_		,
2 Sewer lines 5 Cess pool 3 Watertight sewer lines 6 Seepage pit					8 Sewage la 9 Feedyard			agoon 12 Fertilize 13 Insectici		16 (	other (specify bei	ow)
Direction from	_		rago pa		0 , 00	ayara			many feet?	***************************************	••••••	
FROM TO LITHOLOGIC					LOG			то	PL	UGGING IN	ITERVALS	
0	22	Silty	clay	<u> </u>								
22	27	Silty 0	lay with	Sand								
		tine 70	medium	Sana								
7		D. I. A				3						
completed o	ACTOR'S C on (mo/dav/\	PH LANDOWNE rear) (ה	H'S CERTIFICA	IION: Th	is water w	ell wa	(1) constr	ucted, (2) r and this	reconstructed, or (3) per record is true to the h	olugged und	der my jurisdiction	n and was
Water Well	Contractor's	Licence No	^	710	This W	Vater W	ell Record	was compl	s record is true to the beeted on (mo/day/yr)	7/8/9		
under the bu	usiness nan	ne of 150 Inc.	Ground	Sin	ه يريك	Tin		t	oy (signature) 🥕	オマン	+	

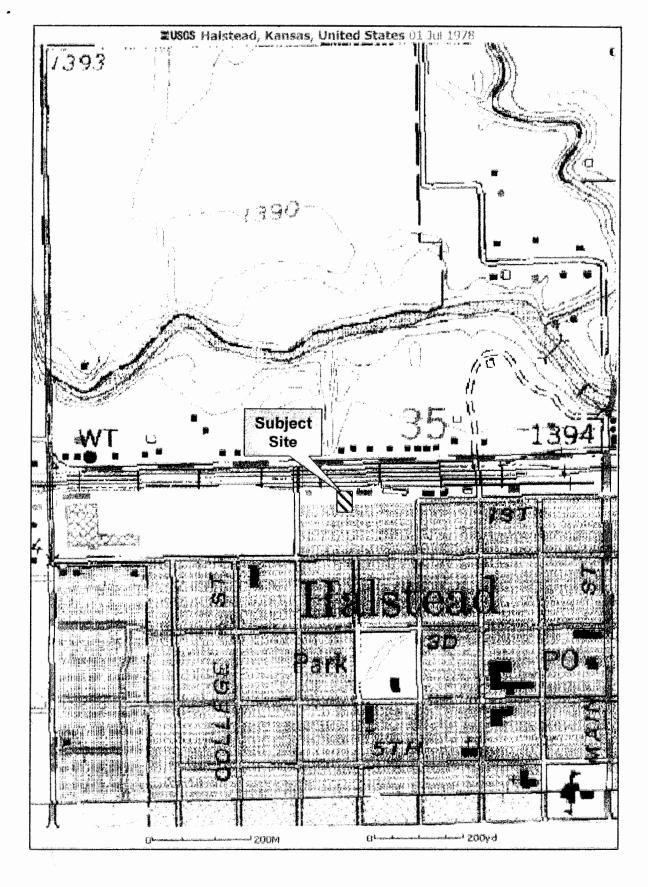


Figure 1 Site Location Map BNSF Leased Property 62650, Thrasher Oil Co.

