528 8027 WATER WELL RECORD Form WWC-5 KSA 82a-1212 ID No. OW-3D-05

1 LOCATION OF WATER WELL: County: Harvey | Fraction: NE 1/4 SE 1/4 SW 1/4 | Section Number: 8 | Township Number: T 23 S | Range Number: R 2 E (W)

Distance and direction from nearest town or city street address of well if located within city?
Approximately 2 1/2 miles west and 4 1/4 miles north of Halstead

2 WATER WELL OWNER: City of Wichita
RR#, St. Address, Box # : 455 N. Main
City, State, ZIP Code : Wichita, KS 67202
Board of Agriculture, Division of Water Resources Application Number:

3 LOCATE WELL'S LOCATION WITH AN "X" IN SECTION BOX:

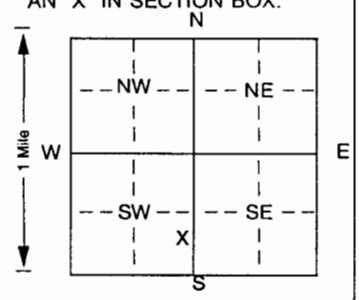

4 DEPTH OF COMPLETED WELL 162 ft. ELEVATION: unknown
Depth(s) Groundwater Encountered 1 ft. 2 ft. 3 ft.
WELL'S STATIC WATER LEVEL 14.31 ft. below land surface measured on mo/day/yr 10-25-05
Pump test data: Well water was not checked ft. after hours pumping gpm
Est. Yield unknown gpm: Well water was ft. after hours pumping gpm
Bore Hole Diameter 6 in. to 180 ft., and in. to ft.

WELL WATER TO BE USED AS: 1 Domestic 2 Irrigation 3 Feedlot 4 Industrial 5 Public water supply 6 Oil field water supply 7 Domestic (lawn & garden) 8 Air conditioning 9 Dewatering 10 Monitoring well 11 Injection well 12 Other (specify below) Observation Well

Was a chemical/bacteriological sample submitted to Department? Yes No ✓ If yes, mo/day/yrs sample was submitted Water Well Disinfected? Yes No ✓

5 TYPE OF BLANK CASING USED: 1 Steel (2) PVC 3 RMP (SR) 4 ABS 5 Wrought iron 6 Asbestos-Cement 7 Fiberglass 8 Concrete tile 9 Other (specify below)
CASING JOINTS: Glued ✓ Clamped Welded Threaded

Blank casing diameter 2 in. to 105 ft., Dia 2 in. to 130 ft., Dia in. to ft
Casing height above land surface 24 in., weight .44 lbs./ft. Wall thickness or gauge No .091

TYPE OF SCREEN OR PERFORATION MATERIAL: (7) PVC
1 Steel 2 Brass 3 Stainless steel 4 Galvanized steel 5 Fiberglass 6 Concrete tile 8 RMP (SR) 9 ABS 10 Asbestos-cement 11 Other (specify) 12 None used (open hole)

SCREEN OR PERFORATION OPENINGS ARE: (3) Mill slot
1 Continuous slot 2 Louvered shutter 4 Key punched 5 Gauzed wrapped 6 Wire wrapped 7 Torch cut 8 Saw cut 9 Drilled holes 10 Other (specify) 11 None (open hole)

SCREEN-PERFORATED INTERVALS: From 105 ft. to 115 ft., From ft. to ft.
From 130 ft. to 160 ft., From ft. to ft.
GRAVEL PACK INTERVALS: From 94 ft. to 180 ft., From ft. to ft.
From ft. to ft., From ft. to ft.

6 GROUT MATERIAL: 1 Neat cement 2 Cement grout 3 Bentonite 4 Other Bentonite Holeplug

Grout Intervals: From ft. to ft., From ft. to ft., From 0 ft. to 94 ft.

What is the nearest source of possible contamination:
1 Septic tank 2 Sewer lines 3 Watertight sewer lines 4 Lateral lines 5 Cess pool 6 Seepage pit 7 Pit privy 8 Sewage lagoon 9 Feedyard 10 Livestock pens 11 Fuel storage 12 Fertilizer storage 13 Insecticide storage 14 Abandoned water well 15 Oil well/Gas well 16 Other (specify below) None known

Direction from well? How many feet?

FROM	TO	LITHOLOGIC LOG	FROM	TO	PLUGGING INTERVALS
0	4	Topsoil	173	180	Shale, black, hard
4	7	Clay, gray, silty, soft			
7	24	Clay, tan, hard			
24	39	Sand, coarse to fine with clay streaks			
39	76	Clay, gray, hard			
76	116	Sand, fine to coarse with clay streaks			
116	127	Clay, tan and green, hard			
127	130	Sand, coarse to fine			
130	134	Clay, tan and gray, hard			
134	137	Sand, fine to coarse with gravel, fine			
137	139	Clay, tan and gray, hard			
139	166	Sand, coarse to medium to fine with gravel, fine			
166	169	Shale, weathered			
169	173	Shale, green and red, hard			

7 CONTRACTOR'S OR LANDOWNER'S CERTIFICATION: This water well was (1) constructed, (2) reconstructed, or (3) plugged under my jurisdiction and was completed on (mo/day/year) 10-25-05 and this record is true to the best of my knowledge and belief. Kansas Water Well Contractor's License No 185 This Water Well Record was completed on (mo/day/yr) 11-9-05 under the business name of Clarke Well & Equipment, Inc. by (signature)

INSTRUCTIONS: Use typewriter or ball point pen. *PLEASE PRESS FIRMLY* and *PRINT* clearly. Please fill in blanks, underline or circle the correct answers. Send top three copies to Kansas Department of Health and Environment, Bureau of Water, Topeka, Kansas 66620-0001. Telephone 785-296-5524. Send one to WATER WELL OWNER and retain one for your records. Fee of $5.00 for each constructed well.