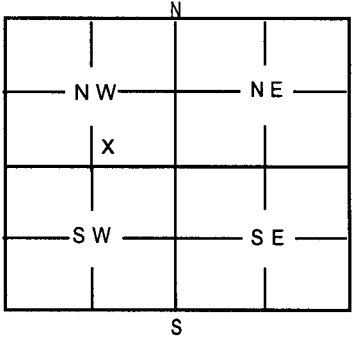


1	LOCATION OF WATER WELL: County: <u>Harvey</u>	Fraction <u>SW 1/4 SE 1/4 NW 1/4</u>	Section Number <u>8</u>	Township Number <u>T 23 S</u>	Range Number <u>R 2 E</u>	<u>W</u>																								
Distance and direction from nearest town or city street address of well if located within city? <u>Approximately 5 1/4 miles east and 2 1/2 miles north of Burrton.</u>																														
2	WATER WELL OWNER: <u>City of Wichita</u> RR#, St. Address, Box # <u>455 N. Main</u> City, State, ZIP Code <u>Wichita, KS 67202</u> Board of Agriculture, Division of Water Resources Application Number:																													
3	MARK WELL'S LOCATION WITH AN "X" IN SECTION BOX: 		4	DEPTH OF WELL <u>133.8</u> ft. WELL'S STATIC WATER LEVEL <u>17.4</u> ft. WELL WAS USED AS: 1 Domestic 5 Public Water Supply 9 Dewatering 2 Irrigation 6 Oil Field Water Supply 10 <u>Monitoring Well</u> 3 Feedlot 7 Domestic (Lawn & Garden) 11 Injection Well 4 Industrial 8 Air Conditioning 12 Other Was a chemical / bacteriological sample submitted to Department? Yes _____ No ☒ If yes, mo/day/yr sample was submitted _____ Water Well Disinfected: Yes ☒ No _____																										
5	TYPE OF BLANK CASING USED: 1 Steel 3 RMP (SR) 5 Wrought 7 Fiberglass 9 Other (Specify below) <u>2 PVC</u> 4 ABS 6 Asbestos-Cement 8 Concrete Tile Blank casing diameter <u>2</u> in. Was casing pulled? Yes _____ No ☒ If yes, how much _____ Casing height above or <u>below</u> land surface <u>48</u> in.																													
6	GROUT PLUG MATERIAL: 1 Neat Cement 2 Cement grout 3 Bentonite <u>4 Other</u> <u>Bentonite Holeplug</u> Grout Plug Intervals: From _____ ft. to _____ ft., From _____ ft. to _____ ft. From <u>4</u> ft. to <u>133.8</u> ft. What is the nearest source of possible contamination: 1 Septic tank 6 Seepage pit 11 Fuel storage 16 <u>Other (specify below)</u> 2 Sewer lines 7 Pit privy 12 Fertilizer storage 3 Watertight sewer lines 8 Sewage lagoon 13 Insecticide storage <u>None known</u> 4 Lateral lines 9 Feedyard 14 Abandoned water well 5 Cess Pool 10 Livestock pens 15 Oil well/Gas well Direction from well? _____ How many feet? _____																													
<table border="1" style="width:100%; border-collapse: collapse;"> <thead> <tr> <th style="width:15%;">FROM</th> <th style="width:15%;">TO</th> <th style="width:70%;">PLUGGING MATERIALS</th> </tr> </thead> <tbody> <tr> <td>133.8</td> <td>4</td> <td>Bentonite Holeplug</td> </tr> <tr> <td>4</td> <td>0</td> <td>Compacted Soil</td> </tr> <tr><td> </td><td> </td><td> </td></tr> <tr><td> </td><td> </td><td> </td></tr> <tr><td> </td><td> </td><td> </td></tr> <tr><td> </td><td> </td><td> </td></tr> <tr><td> </td><td> </td><td> </td></tr> </tbody> </table>							FROM	TO	PLUGGING MATERIALS	133.8	4	Bentonite Holeplug	4	0	Compacted Soil															
FROM	TO	PLUGGING MATERIALS																												
133.8	4	Bentonite Holeplug																												
4	0	Compacted Soil																												
7	CONTRACTOR'S OR LANDOWNER'S CERTIFICATION: This water well was plugged under my jurisdiction and was completed on (mo/day/year) <u>10-24-06</u> and this record is true to the best of my knowledge and belief. Kansas Water Well Contractor's License No. <u>185</u> This Water Well Record was completed on (mo/day/year) <u>11-01-06</u> under the business name of <u>Clarke Well & Equipment, Inc.</u> by (signature) <u>[Signature]</u>																													
INSTRUCTIONS: Use typewriter or ball point pen. Please press firmly and print clearly. Please fill in blanks, underline or circle the correct answers. Send top three copies to Kansas Department of Health & Environment, Bureau of Water, Topeka, Kansas 66620-0001. Telephone: 785/296-3565. Send one to Water Well Owner and retain one for your records.																														