

**WATER WELL PLUGGING RECORD Form WWC-5P KSA 82a-1212 ID NO.**


**1 LOCATION OF WATER WELL:** Fraction 1/4 NW 1/4 NE 1/4 SW 1/4 Section Number 35 Township Number T 23 S Range Number 2  E  W  
 County: Harvey

Street/Rural Address of Well Location; if unknown, distance & direction from nearest town or intersection: If at owner's address, check here  Approximately 500 feet West of 302 W. 1st Street; Halstead, KS

**Global Positioning Systems (GPS) information:**  
 Latitude: 38.00577 (in decimal degrees)  
 Longitude: -97.51208 (in decimal degrees)  
 Elevation: \_\_\_\_\_  
 Horizontal Datum:  WGS84,  NAD83,  NAD27  
 Collection Method: \_\_\_\_\_

**2 WATER WELL OWNER:** BNSF Railway  
 RR#, St. Address, Box #: 4515 Kansas Ave.  
 City, State ZIP Code: Kansas City, KS 66106

GPS unit (Make/Model: Garmin etrek)  
 Digital Map/Photo,  Topographic Map,  Land Survey  
 Est. Accuracy:  < 3 m,  3-5 m,  5-15 m,  > 15 m

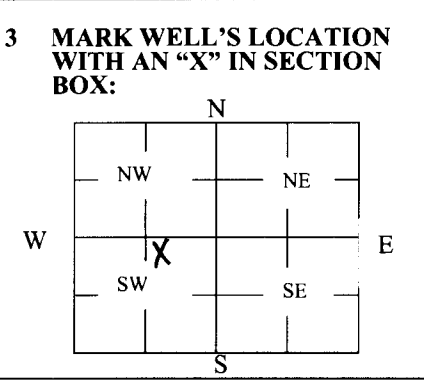

**4 DEPTH OF WELL** 25.75 ft.  
 WELL'S STATIC WATER LEVEL 17.2 ft.  
 WELL WAS USED AS:

Domestic  
 Irrigation  
 Feedlot  
 Industrial

Public Water Supply  
 Oil Field Water Supply  
 Domestic (Lawn & Garden)  
 Air Conditioning

Dewatering  
 Monitoring MW-1  
 Injection Well  
 Other \_\_\_\_\_

Was a chemical/bacteriological sample submitted to Department? Yes  No

**5 TYPE OF BLANK CASING USED:**

Steel  RMP (SR)  Wrought  Fiberglass  Other (Specify below)  
 PVC  ABS  Asbestos-Cement  Concrete Tile

Blank casing diameter 2 in. Was casing pulled? Yes  No  If yes, how much all  
 Casing height above or below land surface 36 in.

**6 GROUT PLUG MATERIAL:**  Neat cement  Cement grout  Bentonite  Other Top Soil/Gravel

Grout Plug Intervals: From 0 ft. to 3 ft., From 3 ft. to 25.75 ft., From — ft. to — ft.

What is the nearest source of possible contamination:

Septic tank  Seepage pit  Fuel storage  Other (specify below)  
 Sewer lines  Pit privy  Fertilizer storage  
 Watertight sewer lines  Sewage lagoon  Insecticide storage  
 Lateral lines  Feedyard  Abandoned water well  
 Cess pool  Livestock pens  Oil well/Gas well

Direction from well? East  
 How many feet? 500'

FROM	TO	PLUGGING MATERIALS	FROM	TO	PLUGGING MATERIALS
0	3	Top Soil/Gravel			
3	25.75	Bentonite			

**7 CONTRACTOR'S OR LANDOWNER'S CERTIFICATION:** This water well was plugged under my jurisdiction and was completed on (mo/day/year) Nov. 22, 2016 and this record is true to the best of my knowledge and belief. Kansas Water Well Contractor's License No. 710. This Water Well Record was completed on (mo/day/year) Nov. 23, 2016 under the business name of Below Ground Surface, Inc. by (signature) Craig R. Hewitt

Send one white copy to Kansas Department of Health & Environment, Geology Section, 1000 SW Jackson Street, Ste. 420, Topeka, KS 66612-1367. Send one copy to WATER WELL OWNER and retain one for your records.  
 Visit us at <http://www.kdheks.gov/waterwell/index.html> Telephone 785-296-5524.