

WATER WELL PLUGGING RECORD Form WWC-5P KSA 82a-1212 ID NO.


1 LOCATION OF WATER WELL: Fraction 1/4 NW 1/4 NE 1/4 SW 1/4 Section Number 35 Township Number T 23 S Range Number 2 E W
 County: Harvey

Street/Rural Address of Well Location; if unknown, distance & direction from nearest town or intersection: If at owner's address, check here Approximately 500 feet West of 302 W. 1st Street; Halstead, KS

Global Positioning Systems (GPS) information:
 Latitude: 38.00566 (in decimal degrees)
 Longitude: -97.51216 (in decimal degrees)
 Elevation: _____
 Horizontal Datum: WGS84, NAD83, NAD27
 Collection Method: _____

2 WATER WELL OWNER: BNSF Railway
 RR#, St. Address, Box #: 4515 Kansas Ave.
 City, State ZIP Code: Kansas City, KS 66106

GPS unit (Make/Model: Garmin etrek)
 Digital Map/Photo, Topographic Map, Land Survey
 Est. Accuracy: < 3 m, 3-5 m, 5-15 m, > 15 m

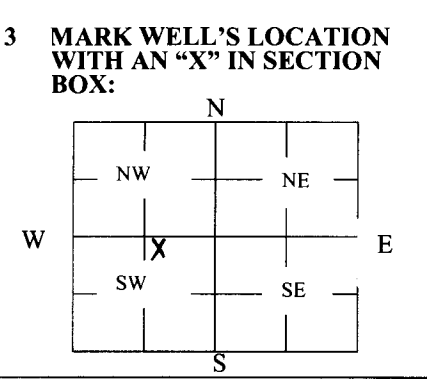

4 DEPTH OF WELL 23.5 ft.
 WELL'S STATIC WATER LEVEL 16.8 ft

WELL WAS USED AS:

Domestic
 Irrigation
 Feedlot
 Industrial

Public Water Supply
 Oil Field Water Supply
 Domestic (Lawn & Garden)
 Air Conditioning

Dewatering
 Monitoring MW-4
 Injection Well
 Other _____

Was a chemical/bacteriological sample submitted to Department? Yes No

5 TYPE OF BLANK CASING USED:

Steel RMP (SR) Wrought Fiberglass Other (Specify below)
 PVC ABS Asbestos-Cement Concrete Tile

Blank casing diameter 2 in. Was casing pulled? Yes No If yes, how much all
 Casing height above or below land surface 36 in.

6 GROUT PLUG MATERIAL: Neat cement Cement grout Bentonite Other Top Soil/Gravel

Grout Plug Intervals: From 0 ft. to 3 ft., From 3 ft. to 23.5 ft., From — ft. to — ft.

What is the nearest source of possible contamination:

Septic tank Seepage pit Fuel storage Other (specify below)
 Sewer lines Pit privy Fertilizer storage
 Watertight sewer lines Sewage lagoon Insecticide storage
 Lateral lines Feedyard Abandoned water well
 Cess pool Livestock pens Oil well/Gas well

Direction from well? East
 How many feet? 500

FROM	TO	PLUGGING MATERIALS	FROM	TO	PLUGGING MATERIALS
0	3	Top Soil/Gravel			
3	23.5	Bentonite			

7 CONTRACTOR'S OR LANDOWNER'S CERTIFICATION: This water well was plugged under my jurisdiction and was completed on (mo/day/year) Nov. 22, 2016 and this record is true to the best of my knowledge and belief. Kansas Water Well Contractor's License No. 710. This Water Well Record was completed on (mo/day/year) Nov. 23, 2016 under the business name of Below Ground Surface, Inc. by (signature) Craig R. Hester

Send one white copy to Kansas Department of Health & Environment, Geology Section, 1000 SW Jackson Street, Ste. 420, Topeka, KS 66612-1367. Send one copy to WATER WELL OWNER and retain one for your records.
 Visit us at <http://www.kdheks.gov/waterwell/index.html> Telephone 785-296-5524.