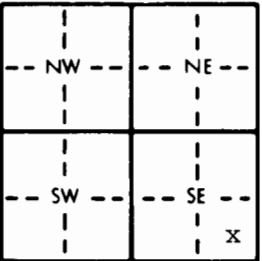
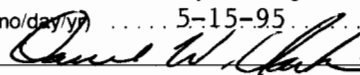


1 LOCATION OF WATER WELL: County: Harvey		Fraction 1/4 SE 1/4 SE 1/4	Section Number 16	Township Number T 23 S	Range Number R 2 EW
Distance and direction from nearest town or city street address of well if located within city? Approximately 2 1/2 miles north and 1 1/4 miles west of Halstead					
2 WATER WELL OWNER: RR#, St. Address, Box # : City, State, ZIP Code		Wichita, City of 12th Floor, City Building 455 N. Main Wichita, KS 67202 Board of Agriculture, Division of Water Resources Application Number:			
3 LOCATE WELL'S LOCATION WITH AN "X" IN SECTION BOX: 		4 DEPTH OF COMPLETED WELL: 55.5 ft. ELEVATION: unknown Depth(s) Groundwater Encountered 1. ft. 2. ft. 3. ft. WELL'S STATIC WATER LEVEL 14.75 ft. below land surface measured on mo/day/yr 4-17-95 Pump test data: Well water was not ch'd. ft. after hours pumping gpm Est. Yield unknown gpm: Well water was ft. after hours pumping gpm Bore Hole Diameter 6 1/2 in. to 170 ft. and in. to ft. WELL WATER TO BE USED AS: 5 Public water supply 8 Air conditioning 11 Injection well 1 Domestic 3 Feedlot 6 Oil field water supply 9 Dewatering 12 Other (Specify below) 2 Irrigation 4 Industrial 7 Lawn and garden only 10 Monitoring well Was a chemical/bacteriological sample submitted to Department? Yes No X; If yes, mo/day/yr sample was submitted Water Well Disinfected? Yes No X			
5 TYPE OF BLANK CASING USED: 1 Steel 3 RMP (SR) 2 PVC 4 ABS		5 Wrought iron 8 Concrete tile CASING JOINTS: Glued X Clamped 6 Asbestos-Cement 9 Other (specify below) Welded 7 Fiberglass Threaded Blank casing diameter 2 in. to 43 ft. Dia in. to ft. Dia in. to ft. Casing height above land surface 30 in. weight 70 lbs./ft. Wall thickness or gauge No. 154 TYPE OF SCREEN OR PERFORATION MATERIAL: 1 Steel 3 Stainless steel 5 Fiberglass 7 PVC 10 Asbestos-cement 2 Brass 4 Galvanized steel 6 Concrete tile 8 RMP (SR) 11 Other (specify) 9 ABS 12 None used (open hole) SCREEN OR PERFORATION OPENINGS ARE: 1 Continuous slot 3 Mill slot 5 Gauzed wrapped 8 Saw cut 11 None (open hole) 2 Louvered shutter 4 Key punched 6 Wire wrapped 9 Drilled holes 7 Torch cut 10 Other (specify) SCREEN-PERFORATED INTERVALS: From 43 ft. to 53 ft. From ft. to ft. From ft. to ft. From ft. to ft. GRAVEL PACK INTERVALS: From 41 ft. to 55 ft. From ft. to ft. From ft. to ft. From ft. to ft.			
6 GROUT MATERIAL: 1 Neat cement 2 Cement grout 3 Bentonite 4 Other Bentonite Holeplug		Grout Intervals: From 55 ft. to 170 ft. From 0 ft. to 41 ft. From 55 ft. to 170 ft. What is the nearest source of possible contamination: 1 Septic tank 4 Lateral lines 7 Pit privy 10 Livestock pens 14 Abandoned water well 2 Sewer lines 5 Cess pool 8 Sewage lagoon 11 Fuel storage 15 Oil well/Gas well 3 Watertight sewer lines 6 Seepage pit 9 Feedyard 12 Fertilizer storage 16 Other (specify below) 13 Insecticide storage None known Direction from well? How many feet?			
FROM TO LITHOLOGIC LOG FROM TO PLUGGING INTERVALS					
0	4	Clay, brown, hard, silty	166	170	Shale, black, hard, silty
4	7	Sand, very fine, loose, clean			
7	14	Clay, tan, soft, sandy			
14	23	Clay, brown, hard			
23	40	Sand, very fine, medium, loose, clean			
40	55	Sand and gravel, fine, medium, loose, clean			
55	57	Clay, yellow, hard, silty			
57	104	Sand and gravel, very fine, medium, loose, clean			
104	122	Clay, white and gray, hard, silty			
122	134.5	Clay, tan, hard, silty			
134.5	160	Sand, very fine, fine, loose, clean			
160	166	Clay, green, hard, silty			
7 CONTRACTOR'S OR LANDOWNER'S CERTIFICATION: This water well was (1) constructed, (2) reconstructed, or (3) plugged under my jurisdiction and was completed on (mo/day/year) 4-17-95 and this record is true to the best of my knowledge and belief. Kansas Water Well Contractor's License No. 185 This Water Well Record was completed on (mo/day/yr) 5-15-95 under the business name of Clarke Well & Equipment, Inc. by (signature) 					
INSTRUCTIONS: Use typewriter or ball point pen. PLEASE PRESS FIRMLY and PRINT clearly. Please fill in blanks, underline or circle the correct answers. Send top three copies to Kansas Department of Health and Environment, Bureau of Water, Topeka, Kansas 66620-0001. Telephone: 913-296-5545. Send one to WATER WELL OWNER and retain one for your records.					