


1 LOCATION OF WATER WELL: County: **Edwards** Fraction: **se se 1/4 se 1/4** Section Number: **36** Township Number: **T 23 S** Range Number: **R 20 E/W**

Distance and direction from nearest town or city street address of well if located within city?  
**2 west and 5 north of Kinsley Kansas**

2 WATER WELL OWNER: **Jim Habiger** Board of Agriculture, Division of Water Resources  
 RR#, St. Address, Box # : **Kinsley Kansas** Application Number:  
 City, State, ZIP Code :

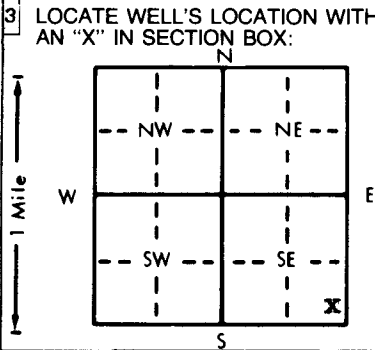

4 DEPTH OF COMPLETED WELL: **140** ft. ELEVATION:  
 Depth(s) Groundwater Encountered 1. **67** ft. 2. ft. 3. ft.  
 WELL'S STATIC WATER LEVEL: **67** ft. below land surface measured on mo/day/yr **8/19/86**  
 Pump test data: Well water was **110** ft. after **1** hours pumping **10** gpm  
 Est. Yield **12** gpm: Well water was ft. after hours pumping gpm  
 Bore Hole Diameter: **8 3/4** in. to **140** ft., and in. to ft.  
 WELL WATER TO BE USED AS:  
 Domestic 3 Feedlot 6 Oil field water supply 9 Dewatering 12 Other (Specify below)  
 2 Irrigation 4 Industrial 7 Lawn and garden only 10 Observation well  
 Was a chemical/bacteriological sample submitted to Department? Yes.....No .....; If yes, mo/day/yr sample was submitted  
 Water Well Disinfected? Yes  No

5 TYPE OF BLANK CASING USED:  
 1 Steel 3 RMP (SR) 5 Wrought iron 8 Concrete tile CASING JOINTS: Glued  Clamped  
 PVC 4 ABS 6 Asbestos-Cement 9 Other (specify below) Welded  
 7 Fiberglass Threaded  
 Blank casing diameter **5** in. to **120** ft., Dia in. to ft., Dia in. to ft.  
 Casing height above land surface **12** in., weight **SDR 26** lbs./ft. Wall thickness or gauge No.  
 TYPE OF SCREEN OR PERFORATION MATERIAL:  PVC 10 Asbestos-cement  
 1 Steel 3 Stainless steel 5 Fiberglass 8 RMP (SR) 11 Other (specify)  
 2 Brass 4 Galvanized steel 6 Concrete tile 9 ABS 12 None used (open hole)  
 SCREEN OR PERFORATION OPENINGS ARE:  
 1 Continuous slot 3 Mill slot 5 Gauzed wrapped  Saw cut 11 None (open hole)  
 2 Louvered shutter 4 Key punched 6 Wire wrapped 9 Drilled holes  
 7 Torch cut 10 Other (specify)  
 SCREEN-PERFORATED INTERVALS: From **120** ft. to **140** ft., From ft. to ft.  
 From ft. to ft., From ft. to ft.  
 GRAVEL PACK INTERVALS: From **65** ft. to **140** ft., From ft. to ft.  
 From ft. to ft., From ft. to ft.

6 GROUT MATERIAL:  Neat cement 2 Cement grout 3 Bentonite 4 Other  
 Grout Intervals: From **4** ft. to **14** ft., From ft. to ft., From ft. to ft.  
 What is the nearest source of possible contamination:  
 Septic tank 4 Lateral lines 7 Pit privy 10 Livestock pens 14 Abandoned water well  
 2 Sewer lines 5 Cess pool 8 Sewage lagoon 11 Fuel storage 15 Oil well/Gas well  
 3 Watertight sewer lines 6 Seepage pit 9 Feedyard 12 Fertilizer storage 16 Other (specify below)  
 13 Insecticide storage  
 Direction from well? **NW** How many feet? **75**

FROM	TO	LITHOLOGIC LOG	FROM	TO	LITHOLOGIC LOG
0	3	Top Soil			
3	8	Brown Clay			
8	55	Tan Clay			
55	86	Clay and Sand Mixed			
86	127	Clay			
127	140	Clay with streaks of Chipped Brown rock			

7 CONTRACTOR'S OR LANDOWNER'S CERTIFICATION: This water well was  constructed, (2) reconstructed, or (3) plugged under my jurisdiction and was completed on (mo/day/year) **8/19/86** and this record is true to the best of my knowledge and belief. Kansas Water Well Contractor's License No. **224** This Water Well Record was completed on (mo/day/yr) **1/4/87** under the business name of **Carl Hayse Water Well Service** by (signature) *Carl Hayse*

INSTRUCTIONS: Use typewriter or ball point pen, PLEASE PRESS FIRMLY and PRINT clearly. Please fill in blanks, underline or circle the correct answers. Send top three copies to Kansas Department of Health and Environment, Division of Environment, Environmental Geology Section, Topeka, KS 66620. Send one to WATER WELL OWNER and retain one for your records.

OFFICE USE ONLY T R E/W SEC 1/4 1/4 1/4