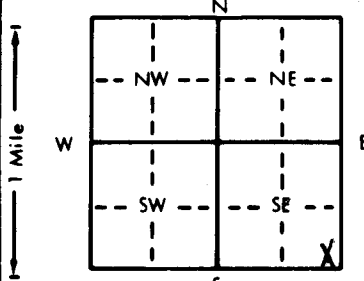


1 LOCATION OF WATER WELL: County: <b>Edwards</b>	Fraction <b>SE 1/4 SE 1/4 SE 1/4</b>	Section Number <b>28</b>	Township Number <b>T 23 S</b>	Range Number <b>R 20 XE/W</b>
---	---	-----------------------------	----------------------------------	----------------------------------

Distance and direction from nearest town or city street address of well if located within city?  
**6 north 5 west of Kinsley, Ks.**

2 WATER WELL OWNER: **Mike Klenke**  
 RR#, St. Address, Box #: **RR2- Box 110**  
 City, State, ZIP Code: **Kinsley, Ks. 67547**

Board of Agriculture, Division of Water Resources  
Application Number:

3 LOCATE WELL'S LOCATION WITH AN "X" IN SECTION BOX: 	4 DEPTH OF COMPLETED WELL: <b>158</b> ft. ELEVATION: Depth(s) Groundwater Encountered 1. . . . . ft. 2. . . . . ft. 3. . . . . ft. WELL'S STATIC WATER LEVEL: <b>8.7</b> ft. below land surface measured on mo/day/yr <b>11-13-98</b> Pump test data: Well water was . . . . . ft. after . . . . . hours pumping . . . . . gpm Est. Yield . . . . . gpm: Well water was . . . . . ft. after . . . . . hours pumping . . . . . gpm Bore Hole Diameter: <b>9.7/8</b> in. to <b>158</b> ft., and . . . . . in. to . . . . . ft. WELL WATER TO BE USED AS: 1 <u>Domestic</u> 3 Feedlot 6 Oil field water supply 9 Dewatering 12 Other (Specify below) 2 Irrigation 4 Industrial 7 Lawn and garden only 10 Monitoring well Was a chemical/bacteriological sample submitted to Department? Yes . . . . . No <input checked="" type="checkbox"/> . . . . .; If yes, mo/day/yr sample was submitted Water Well Disinfected? Yes <b>hth</b> No
--	---

5 TYPE OF BLANK CASING USED:  
 1 Steel 3 RMP (SR) 5 Wrought iron 8 Concrete tile CASING JOINTS: Glued  Clamped . . . . .  
 2 PVC 4 ABS 6 Asbestos-Cement 9 Other (specify below) Welded . . . . .  
 7 Fiberglass Threaded . . . . .

Blank casing diameter: **5** in. to **138** ft., Dia . . . . . in. to . . . . . ft., Dia . . . . . in. to . . . . . ft.  
 Casing height above land surface: **2'** in., weight **SDR26** lbs./ft. Wall thickness or gauge No. . . . .

TYPE OF SCREEN OR PERFORATION MATERIAL:  
 1 Steel 3 Stainless steel 5 Fiberglass 7 PVC 10 Asbestos-cement  
 2 Brass 4 Galvanized steel 6 Concrete tile 9 ABS 11 Other (specify) . . . . .  
 12 None used (open hole)

SCREEN OR PERFORATION OPENINGS ARE:  
 1 Continuous slot 3 Mill slot 5 Gauzed wrapped 8 Saw cut 11 None (open hole)  
 2 Louvered shutter 4 Key punched 6 Wire wrapped 9 Drilled holes  
 7 Torch cut 10 Other (specify) . . . . .

SCREEN-PERFORATED INTERVALS: From . . . . . **138** ft. to . . . . . **158** ft., From . . . . . ft. to . . . . . ft.  
 From . . . . . ft. to . . . . . ft., From . . . . . ft. to . . . . . ft.  
 GRAVEL PACK INTERVALS: From . . . . . **158** ft. to . . . . . **20** ft., From . . . . . ft. to . . . . . ft.  
 From . . . . . ft. to . . . . . ft., From . . . . . ft. to . . . . . ft.

6 GROUT MATERIAL: 1 Neat cement 2 Cement grout 3 Bentonite 4 Other **hole plug**  
 Grout Intervals: From **20** ft. to **3** ft., From . . . . . ft. to . . . . . ft., From . . . . . ft. to . . . . . ft.  
 What is the nearest source of possible contamination:  
 1 Septic tank 4 Lateral lines 7 Pit privy 10 Livestock pens 14 Abandoned water well  
 2 Sewer lines 5 Cess pool 8 Sewage lagoon 11 Fuel storage 15 Oil well/Gas well  
 3 Watertight sewer lines 6 Seepage pit 9 Feedyard 12 Fertilizer storage 16 Other (specify below)  
 13 Insecticide storage **house**

Direction from well? **north east** How many feet? **300'**

FROM	TO	LITHOLOGIC LOG	FROM	TO	PLUGGING INTERVALS
0	3	Top soil	119	125	Blue gray sahle
3	26	Brown & white clay	125	126	Hard dark brown rock
26	35	Yellow brown chalky clay, brown rock			
35	50	Blue gray, yellow brown clay, redish brown rock			
50	56	Blue gray clay			
56	60	Redish brown rock	126	130	Sandy light gray shale
60	65	Blue gray clay	130	158	Sand rock
65	70	Blue gray gritty clay			
70	80	Hard sand rock			
80	90	Light gray sandy clay			
90	96	Dark blue gray shale			
96	100	Sand rock & sandy light gray clay			
100	115	Sand rock			
115	118	Hard brown rock			
118	119	Sand rock			

7 CONTRACTOR'S OR LANDOWNER'S CERTIFICATION: This water well was (1) constructed, (2) reconstructed, or (3) plugged under my jurisdiction and was completed on (mo/day/year) **11-24-98** and this record is true to the best of my knowledge and belief. Kansas Water Well Contractor's License No. **134** This Water Well Record was completed on (mo/day/yr) **12-3-98** under the business name of **Rosencrantz-Bemis** by (signature) *Fredia Hodson*