


HODGEMAN

1 LOCATION OF WATER WELL: Fraction Section Number Township Number Range Number
COUNTY: ~~024 EDWARDS~~ SE 1/4 SE 1/4 SW 1/4 13 T 23 S R 21 W

Distance and direction from nearest town or city street address of well if located within city?
10 N. 1 W. OF OFFERLE, KS

2 WATER WELL OWNER: BRIAN HORACEK 374
RR#, St. Address, Box #: RT2 BOX 99 Board of Agriculture, Division of Water Resources
City, State, ZIP code: OFFERLE, KS 67547- Application Number:

3 LOCATE WELL'S LOCATION WITH AN "X" IN SECTION BOX:

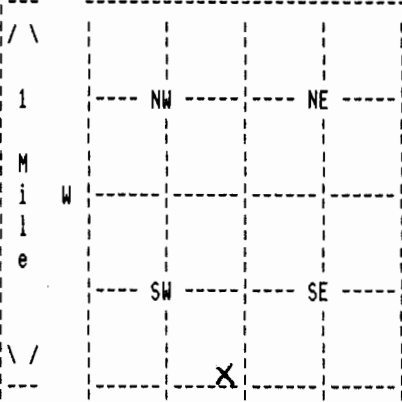

4 DEPTH OF COMPLETED WELL 70 ELEVATION: 0
Depth(s) Groundwater Encountered 1. 40 ft. 2. 0 ft. 3. 0 ft.

WELL'S STATIC WATER LEVEL 40 ft. below land surface measured on mo/day/yr
Pump test data: Well water was 0 ft. after 0 hours pumping 0 gpm

Estimated Yield 0 gpm: Well water was 0 ft. after 0 hours pumping 0 gpm

Bore Hole Diameter 8.75 in. to 70 ft., and in. to 0 ft.

WELL WATER TO BE USED AS: 01 DOMESTIC

Was a chemical/bacteriological sample submitted to department? No ;
If yes, mo/day/yr sample was submitted Water well disinfected? Yes

5 TYPE OF BLANK CASING USED: 02 PVC CASING JOINTS: GLUED
Blank casing diameter 8 in. to 50 ft., Dia in. to 0 ft., Dia in. to 0 ft.
Casing height above land surface 12 in., weight 0 lbs/ft. Wall thickness or gauge No. 40
TYPE OF SCREEN OR PERFORATION MATERIAL: 07 PVC
SCREEN OR PERFORATION OPENINGS ARE: 08 SAW CUT

SCREEN PERFORATED INTERVALS: From 50 ft. to 70 ft., From 0 ft. to 0 ft.
From 0 ft. to 0 ft., From 0 ft. to 0 ft.
GRAVEL PACK INTERVALS: From 25 ft. to 70 ft., From 0 ft. to 0 ft.
From 0 ft. to 0 ft., From 0 ft. to 0 ft.

6 GROUT MATERIAL 03 BENTONITE
Grout Intervals: From 4 ft. to 25 ft., From 0 ft. to 0 ft., From 0 ft. to 0 ft.
What is the nearest source of possible contamination: 01 SEPTIC TANK
Direction from well? NW How many feet? 90

FROM	TO	LITHOLOGIC LOG	FROM	TO	PLUGGING INTERVALS
0	5	BROWN CLAY			
5	40	TAN CLAY			
40	66	TAN CLAY SANDY			
66	67	SANDSTONE			
67	69	WHITE CLAY			
69	70	19 SHALE			

7 CONTRACTOR'S OR LANDOWNER'S CERTIFICATION: This water well was Constructed under my jurisdiction and was completed on (mo/day/year) 11/22/96 and this record is true to the best of my knowledge and belief. Kansas Water Well Contractor's License No. 224 This Water Well Record was completed on (mo/day/yr) 12/18/96 under the business name of CARL HAYSE WATER WELL SVC by (signature) Carl Hayse