


1 LOCATION OF WATER WELL: Fraction SW 1/4 NE 1/4 SE 1/4 Section Number 7 Township Number T 23 S Range Number R 21 E/W  
 County: HODGEMAN

Distance and direction from nearest town or city street address of well if located within city?  
 4 South and 3 East of Hanston, Kansas

2 WATER WELL OWNER: Mr. Bob Peintner  
 RR#, St. Address, Box #: Board of Agriculture, Division of Water Resources  
 City, State, ZIP Code: Spearville, KS 67876 Application Number: ----

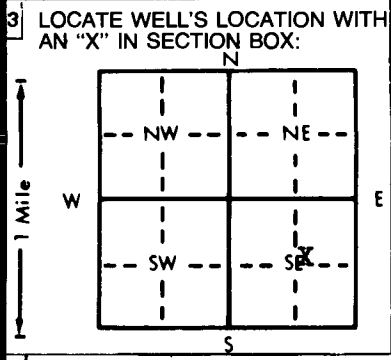

4 DEPTH OF COMPLETED WELL: 240 ft. ELEVATION: Slope  
 Depth(s) Groundwater Encountered 1. Not available ft. 2. ft. 3. ft.  
 WELL'S STATIC WATER LEVEL: 137 ft. below land surface measured on mo/day/yr: July 30, 1986  
 Pump test data: Well water was ft. after hours pumping gpm  
 Est. Yield: 20 gpm; Well water was ft. after hours pumping gpm  
 Bore Hole Diameter: 9 7/8 in. to 240 ft., and in. to ft.  
 WELL WATER TO BE USED AS:  
 5 Public water supply 8 Air conditioning 11 Injection well  
 XX Domestic 3 Feedlot 6 Oil field water supply 9 Dewatering 12 Other (Specify below)  
 2 Irrigation 4 Industrial 7 Lawn and garden only 10 Observation well  
 Was a chemical/bacteriological sample submitted to Department? Yes No XX; If yes, mo/day/yr sample was submitted  
 Water Well Disinfected? Yes XX No

5 TYPE OF BLANK CASING USED:  
 1 Steel 3 RMP (SR) 5 Wrought iron 8 Concrete tile CASING JOINTS: Glued XX Clamped  
 XX PVC 4 ABS 6 Asbestos-Cement 9 Other (specify below) Welded  
 7 Fiberglass Threaded  
 Blank casing diameter: 5 in. to 200 ft., Dia in. to ft., Dia in. to ft.  
 Casing height above land surface: 15 in., weight 2.8 lbs./ft. Wall thickness or gauge No. 265  
 TYPE OF SCREEN OR PERFORATION MATERIAL: XX PVC 10 Asbestos-cement  
 1 Steel 3 Stainless steel 5 Fiberglass 8 RMP (SR) 11 Other (specify)  
 2 Brass 4 Galvanized steel 6 Concrete tile 9 ABS 12 None used (open hole)  
 SCREEN OR PERFORATION OPENINGS ARE:  
 1 Continuous slot 3 Mill slot 5 Gauzed wrapped XX Saw cut 11 None (open hole)  
 2 Louvered shutter 4 Key punched 6 Wire wrapped 9 Drilled holes  
 7 Torch cut 10 Other (specify)  
 SCREEN-PERFORATED INTERVALS: From 200 ft. to 240 ft., From ft. to ft.  
 From ft. to ft., From ft. to ft.  
 GRAVEL PACK INTERVALS: From 10 ft. to 240 ft., From ft. to ft.  
 From ft. to ft., From ft. to ft.

6 GROUT MATERIAL: XX Neat cement 2 Cement grout 3 Bentonite 4 Other  
 Grout intervals: From 0 ft. to 10 ft., From ft. to ft., From ft. to ft.  
 What is the nearest source of possible contamination: NONE  
 1 Septic tank 4 Lateral lines 7 Pit privy 10 Livestock pens 14 Abandoned water well  
 2 Sewer lines 5 Cess pool 8 Sewage lagoon 11 Fuel storage 15 Oil well/Gas well  
 3 Watertight sewer lines 6 Seepage pit 9 Feedyard 12 Fertilizer storage 16 Other (specify below)  
 13 Insecticide storage  
 Direction from well? How many feet?

FROM	TO	LITHOLOGIC LOG	FROM	TO	LITHOLOGIC LOG
0	3	Topsoil			
3	18	Clay			
18	137	Black Shale			
137	145	Brown Sandstone			
145	182	Black Shale			
182	238	Brown Sandstone			
238	240	Black Shale			

7 CONTRACTOR'S OR LANDOWNER'S CERTIFICATION: This water well was (1) constructed, (2) reconstructed, or (3) plugged under my jurisdiction and was completed on (mo/day/year) July 30, 1986 and this record is true to the best of my knowledge and belief. Kansas Water Well Contractor's License No. 252 This Water Well Record was completed on (mo/day/year) August 22, 1986 under the business name of FRIESEN WINDMILL & SUPPLY INC. by (signature)

INSTRUCTIONS: Use typewriter or ball point pen, PLEASE PRESS FIRMLY and PRINT clearly. Please fill in blanks, underline or circle the correct answers. Send top three copies to Kansas Department of Health and Environment, Division of Environment, Environmental Geology Section, Topeka, KS 66620. Send one to WATER WELL OWNER and retain one for your records.

6600000098-90

OFFICE USE ONLY

T

R

EW

SEC

1/4

1/4

1/4