


1 LOCATION OF WATER WELL: Fraction NW 1/4 SE 1/4 SE 1/4 Section Number 8 Township Number T 23 S Range Number R 21 E/W  
 County: HODGEMAN

Distance and direction from nearest town or city street address of well if located within city?  
 4 East and 3 South of Hanston, Kansas EAST WELL

2 WATER WELL OWNER: Ron Herrmann  
 RR#, St. Address, Box # : Board of Agriculture, Division of Water Resources  
 City, State, ZIP Code : Offerle, Kansas 67563 Application Number: ---

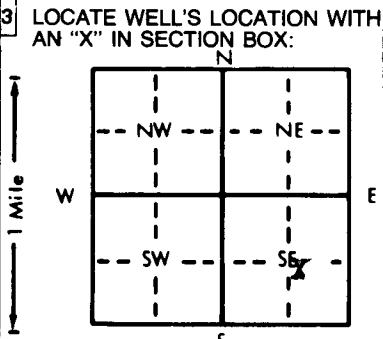

4 DEPTH OF COMPLETED WELL... 200... ft. ELEVATION: Hill  
 Depth(s) Groundwater Encountered 1. Not available 2. ft. 3. ft.  
 WELL'S STATIC WATER LEVEL ... 121... ft. below land surface measured on mo/day/yr August 22, 1985  
 Pump test data: Well water was ft. after hours pumping gpm  
 Est. Yield ... 10... gpm: Well water was ft. after hours pumping gpm  
 Bore Hole Diameter. 9 7/8 in. to 200 ft., and in. to ft.  
 WELL WATER TO BE USED AS: 5 Public water supply 8 Air conditioning 11 Injection well  
 XX Domestic 3 Feedlot 6 Oil field water supply 9 Dewatering 12 Other (Specify below)  
 2 Irrigation 4 Industrial 7 Lawn and garden only 10 Observation well  
 Was a chemical/bacteriological sample submitted to Department? Yes. XX No; If yes, mo/day/yr sample was submitted September 3, 1985  
 Water Well Disinfected? Yes XX No

5 TYPE OF BLANK CASING USED: 5 Wrought iron 8 Concrete tile CASING JOINTS: Glued XX Clamped  
 1 Steel 3 RMP (SR) 6 Asbestos-Cement 9 Other (specify below) Welded  
 XX PVC 4 ABS 7 Fiberglass Threaded  
 Blank casing diameter ... 5... in. to 160... ft., Dia ... in. to ft., Dia ... in. to ft.  
 Casing height above land surface ... 24... in., weight ... 2.8... lbs./ft. Wall thickness or gauge No. ... 265  
 TYPE OF SCREEN OR PERFORATION MATERIAL: XX PVC 10 Asbestos-cement  
 1 Steel 3 Stainless steel 5 Fiberglass 8 RMP (SR) 11 Other (specify)  
 2 Brass 4 Galvanized steel 6 Concrete tile 9 ABS 12 None used (open hole)  
 SCREEN OR PERFORATION OPENINGS ARE: 5 Gauzed wrapped 8 Saw cut 11 None (open hole)  
 1 Continuous slot 3 Mill slot 6 Wire wrapped 9 Drilled holes  
 2 Louvered shutter 4 Key punched 7 Torch cut 10 Other (specify)  
 SCREEN-PERFORATED INTERVALS: From ... 160... ft. to ... 200... ft., From ... ft. to ... ft.  
 From ... ft. to ... ft., From ... ft. to ... ft.  
 GRAVEL PACK INTERVALS: From ... 10... ft. to ... 200... ft., From ... ft. to ... ft.  
 From ... ft. to ... ft., From ... ft. to ... ft.

6 GROUT MATERIAL: XX Neat cement 2 Cement grout 3 Bentonite 4 Other  
 Grout Intervals: From ... 0... ft. to ... 10... ft., From ... ft. to ... ft., From ... ft. to ... ft.  
 What is the nearest source of possible contamination: NONE  
 1 Septic tank 4 Lateral lines 7 Pit privy 10 Livestock pens 14 Abandoned water well  
 2 Sewer lines 5 Cess pool 8 Sewage lagoon 11 Fuel storage 15 Oil well/Gas well  
 3 Watertight sewer lines 6 Seepage pit 9 Feedyard 12 Fertilizer storage 16 Other (specify below)  
 13 Insecticide storage  
 Direction from well? How many feet?

FROM	TO	LITHOLOGIC LOG	FROM	TO	LITHOLOGIC LOG
0	2	Topsoil			
2	21	Clay			
21	36	Caliche			
36	144	Black Shale			
144	180	Poor Brown Sandstone			
180	200	Black Shale			

7 CONTRACTOR'S OR LANDOWNER'S CERTIFICATION: This water well was (1) constructed, (2) reconstructed, or (3) plugged under my jurisdiction and was completed on (mo/day/year) August 26, 1985 and this record is true to the best of my knowledge and belief. Kansas Water Well Contractor's License No. 252 This Water Well Record was completed on (mo/day/yr) September 3, 1985 under the business name of FRIESEN WINDMILL & SUPPLY INC. by (signature)

INSTRUCTIONS: Use typewriter or ball point pen, PLEASE PRESS FIRMLY and PRINT clearly. Please fill in blanks, underline or circle the correct answers. Send top three copies to Kansas Department of Health and Environment, Division of Environment, Environmental Geology Section, Topeka, KS 66620. Send one to WATER WELL OWNER and retain one for your records.

8700000000-22