


1 LOCATION OF WATER WELL: County: Holgerman Fraction: SE 1/4 SE 1/4 SE 1/4 Section Number: 13 Township Number: T 23 S Range Number: R 21 EW

Distance and direction from nearest town or city street address of well if located within city?
7 E E 4 S of Houston

2 WATER WELL OWNER: Shelby Wilson
RR#, St. Address, Box # : 715 Capitol Board of Agriculture, Division of Water Resources
City, State, ZIP Code : Kinaley, Ks 67547 Application Number:

3 LOCATE WELL'S LOCATION WITH AN "X" IN SECTION BOX:

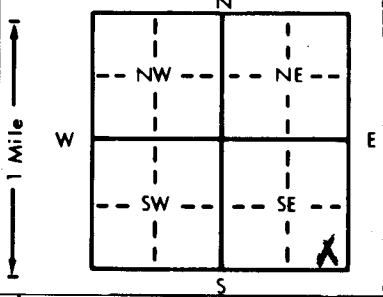

4 DEPTH OF COMPLETED WELL: 270 ft. ELEVATION:

Depth(s) Groundwater Encountered 1. 250 ft. 2. . ft. 3. . ft.
WELL'S STATIC WATER LEVEL 180 ft. below land surface measured on mo/day/yr
Pump test data: Well water was N/A ft. after . . . hours pumping . . . gpm
Est. Yield 20 gpm: Well water was . . . ft. after . . . hours pumping . . . gpm
Bore Hole Diameter: 9 in. to . . . ft., and . . . in. to . . . ft.
WELL WATER TO BE USED AS:
5 Public water supply 8 Air conditioning 11 Injection well
 Domestic 3 Feedlot 6 Oil field water supply 9 Dewatering 12 Other (Specify below)
2 Irrigation 4 Industrial 7 Lawn and garden only 10 Observation well
Was a chemical/bacteriological sample submitted to Department? Yes No . . . ; If yes, mo/day/yr sample was submitted
Water Well Disinfected? Yes No

5 TYPE OF BLANK CASING USED:
1 Steel 3 RMP (SR) 5 Wrought iron 8 Concrete tile CASING JOINTS: Glued Clamped . . .
2 PVC 4 ABS 6 Asbestos-Cement 9 Other (specify below) Welded . . .
7 Fiberglass . . . Threaded . . .

Blank casing diameter: 5 in. to 250 ft., Dia . . . in. to . . . ft., Dia . . . in. to . . . ft.
Casing height above land surface: 15 in., weight 250 lbs./ft. Wall thickness or gauge No. 20

TYPE OF SCREEN OR PERFORATION MATERIAL:
1 Steel 3 Stainless steel 5 Fiberglass 8 RMP (SR) 10 Asbestos-cement
2 Brass 4 Galvanized steel 6 Concrete tile 9 ABS 11 Other (specify) . . .
12 None used (open hole)

SCREEN OR PERFORATION OPENINGS ARE:
1 Continuous slot 3 Mill slot 5 Gauzed wrapped 8 Saw cut 11 None (open hole)
2 Louvered shutter 4 Key punched 6 Wire wrapped 9 Drilled holes
7 Torch cut 10 Other (specify) . . .

SCREEN-PERFORATED INTERVALS: From 20 ft. to 270 ft., From . . . ft. to . . . ft.
GRAVEL PACK INTERVALS: From 270 ft. to 20 ft., From . . . ft. to . . . ft.

6 GROUT MATERIAL: 1 Neat cement 2 Cement grout 3 Bentonite 4 Other . . .
Grout intervals: From 20 ft. to 0 ft., From . . . ft. to . . . ft., From . . . ft. to . . . ft.

What is the nearest source of possible contamination:
1 Septic tank 4 Lateral lines 7 Pit privy 10 Livestock pens 14 Abandoned water well
2 Sewer lines 5 Access pool 8 Sewage lagoon 11 Fuel storage 15 Oil well/Gas well
3 Watertight sewer lines 6 Seepage pit 9 Feedyard 12 Fertilizer storage 16 Other (specify below)
13 Insecticide storage
Direction from well? S How many feet? 100

FROM	TO	LITHOLOGIC LOG	FROM	TO	LITHOLOGIC LOG
0	2	TOPSOIL			
2	35	CLAY			
35	200	Blue Clay			
200	205	SAND Rock			
205	250	28 Rock			
250	290	23 Sandstone			

7 CONTRACTOR'S OR LANDOWNER'S CERTIFICATION: This water well was (1) constructed, (2) reconstructed, or (3) plugged under my jurisdiction and was completed on (mo/day/year) 15.7.83 and this record is true to the best of my knowledge and belief. Kansas Water Well Contractor's License No. 111 This Water Well Record was completed on (mo/day/yr) 15.7.83 under the business name of Craig Penn by (signature) Craig Penn

INSTRUCTIONS: Use typewriter or ball point pen, PLEASE PRESS FIRMLY and PRINT clearly. Please fill in blanks, underline or circle the correct answers. Send top three copies to Kansas Department of Health and Environment, Division of Environment, Environmental Geology Section, Topeka, KS 66620. Send one to WATER WELL OWNER and retain one for your records.

DP