


WATER WELL RECORD Form WWC-5 KSA 82a-1212

1 LOCATION OF WATER WELL: Fraction Section Number Township Number Range Number
 COUNTY: HODGEMAN SE 1/4 NE 1/4 NE 1/4 28 T 23 S R 21 W

Distance and direction from nearest town or city street address of well if located within city?
 FROM HANSTON - E ON 156 TO P RD. E TO 233 RD. & 7 1/2 SOUTH

2 WATER WELL OWNER: GLEASON, JAMES Board of Agriculture, Division of Water Resources
 RR#, St. Address, Box #: 17761 SE 233 Application Number:
 City, State, ZIP code: KINSLEY, KS 67547-

3 LOCATE WELL'S LOCATION WITH AN "X" IN SECTION BOX:

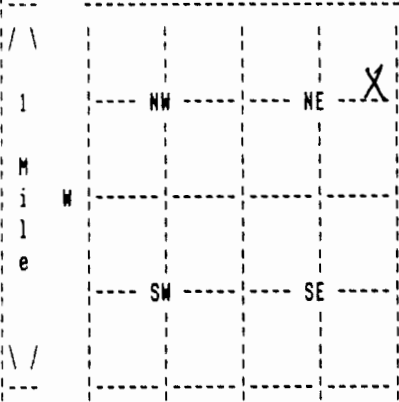

4 DEPTH OF COMPLETED WELL 400 ELEVATION: 0
 Depth(s) Groundwater Encountered 1. 0 ft. 2. 0 ft. 3. 0 ft.

WELL'S STATIC WATER LEVEL 174 ft. below land surface measured on mo/day/yr 06/24/10
 Pump test data: Well water was 0 ft. after 0 hours pumping 0 gpm

Estimated Yield 35 gpm: Well water was 0 ft. after 0 hours pumping 0 gpm

Bore Hole Diameter 10 in. to 400 ft., and in. to 0 ft.

WELL WATER TO BE USED AS: DOMESTIC

Was a chemical/bacteriological sample submitted to department? No ;
 If yes, mo/day/yr sample was submitted Water well disinfected? Yes

5 TYPE OF BLANK CASING USED: CERTA LOC CASIM CASING JOINTS: CERTA-LOC
 Blank casing diameter 5 in. to 400 ft., Dia in. to 0 ft., Dia in. to 0 ft.
 Casing height above land surface 12 in., weight 200 lbs/ft. Wall thickness or gauge No. 21 17
 TYPE OF SCREEN OR PERFORATION MATERIAL: PVC
 SCREEN OR PERFORATION OPENINGS ARE: SAW CUT

SCREEN PERFORATED INTERVALS: From 320 ft. to 400 ft., From 0 ft. to 0 ft.
 From 0 ft. to 0 ft., From 0 ft. to 0 ft.
 GRAVEL PACK INTERVALS: From 25 ft. to 400 ft., From 0 ft. to 0 ft.
 From 0 ft. to 0 ft., From 0 ft. to 0 ft.

6 GROUT MATERIAL BENTONITE
 Grout Intervals: From 5 ft. to 25 ft., From 0 ft. to 0 ft., From 0 ft. to 0 ft.
 What is the nearest source of possible contamination: ABANDONED WELL
 Direction from well? SOUTHEAST How many feet? 20

FROM	TO	LITHOLOGIC LOG	FROM	TO	PLUGGING INTERVALS
0	20	01 TOPSOIL 05 CLAY 35 CALACHIE			
20	40	14 WHITE CLAY 35 CALACHIE			
40	60	35 CALACHIE 07 BLUE SHALE			
60	110	07 BLUE SHALE 08 ROCK LAYERS			
110	120	36 BLUE CLAY 08 ROCK LAYERS			
120	140	36 BLUE CLAY			
140	170	16 GRAY CLAY			
170	180	26 RED CLAY			
180	200	16 GRAY CLAY 26 RED CLAY			
200	220	16 GRAY CLAY 26 RED CLAY 29 SANDSTONE			

7 CONTRACTOR'S OR LANDOWNER'S CERTIFICATION: This water well was constructed under my jurisdiction and was completed on (mo/day/year) 06/25/10 and this record is true to the best of my knowledge and belief. Kansas Water Well Contractor's License No. 179 This Water Well Record was completed on (mo/day/yr) 07/05/10 under the business name of JOE'S WELL SERVICE, INC. by (signature) Judith Cricht

(Continued)

WATER WELL RECORD Form WNC-5 KSA 82a-1212

1 LOCATION OF WATER WELL:	Fraction	Section Number	Township Number	Range Number
COUNTY: HODGEMAN	SE 1/4 NE 1/4 NE 1/4	28	T 23 S	R 21 W

2 WATER WELL OWNER:	GLEASON, JAMES	Board of Agriculture, Division of Water Resources
RR#, St. Address, Box # :	17761 SE 233	Application Number:
City, State, ZIP code :	KINSLEY, KS 67547-	

FROM	TO	LITHOLOGIC LOG
220	280	16 GRAY CLAY 26 RED CLAY
280	300	16 GRAY CLAY 26 RED CLAY 29 SANDSTONE
300	380	29 SANDSTONE
380	420	29 SANDSTONE 16 GRAY CLAY
420	460	16 GRAY CLAY 29 SANDSTONE

7 CONTRACTOR'S OR LANDOWNER'S CERTIFICATION: This water well was Constructed under my jurisdiction and was completed on (mo/day/year) 06/25/10 and this record is true to the best of my knowledge and belief. Kansas Water Well Contractor's License No. 179 This Water Well Record was completed on (mo/day/yr) 07/05/10 under the business name of JOE'S WELL SERVICE, INC. by (signature) *Jessie Crist*