


1 LOCATION OF WATER WELL: Fraction Section Number Township Number Range Number  
 County: Hodgeman SE 1/4 NW 1/4 NW 1/4 7 T 23 S R 22W E/W

Distance and direction from nearest town or city street address of well if located within city?  
5 E of Jetmore, Kansas

2 WATER WELL OWNER: W. G. Lupfer White & Ellis Drilling Lupfer1-7  
 RR#, St. Address, Box #: Route 1 401 E Douglas, Suite 500 Board of Agriculture, Division of Water Resources  
 City, State, ZIP Code: Hanston, Ks. 67849 Wichita, Kansas 67202 Application Number: Unknown

3 LOCATE WELL'S LOCATION WITH AN "X" IN SECTION BOX: 4 DEPTH OF COMPLETED WELL... 335 ft. ELEVATION: Unknown  
 Depth(s) Groundwater Encountered 1110 ft. 2. . . . . ft. 3. . . . . ft.

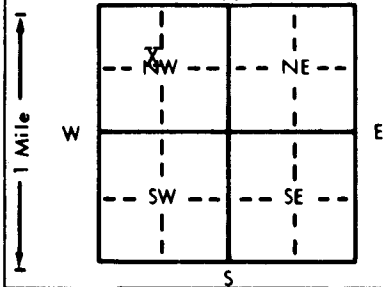

WELL'S STATIC WATER LEVEL . . . . . 110 ft. below land surface measured on mo/day/yr . . . . . 9/22/85  
 Pump test data: Well water was . . . . . ft. after . . . . . hours pumping . . . . . gpm  
 Est. Yield . . . 60 . . . gpm: Well water was . . . . . ft. after . . . . . hours pumping . . . . . gpm  
 Bore Hole Diameter . . . . . 8 . . . in. to 335 . . . . . ft., and . . . . . in. to . . . . . ft.  
 WELL WATER TO BE USED AS: 5 Public water supply 8 Air conditioning 11 Injection well  
 1 Domestic 3 Feedlot 6 Oil field water supply 9 Dewatering 12 Other (Specify below)  
 2 Irrigation 4 Industrial 7 Lawn and garden only 10 Observation well  
 Was a chemical/bacteriological sample submitted to Department? Yes . . . . . No . . . . .; If yes, mo/day/yr sample was submitted  
 Water Well Disinfected? Yes No

5 TYPE OF BLANK CASING USED: 5 Wrought iron 8 Concrete tile CASING JOINTS: Glued . . . . . Clamped . . . . .  
 1 Steel 3 RMP (SR) 6 Asbestos-Cement 9 Other (specify below) Welded . . . . .  
 2 PVC 4 ABS 7 Fiberglass . . . . . Threaded . . . . .  
 Blank casing diameter . . . . . 5 . . . . . in. to 275 . . . . . ft., Dia . . . . . in. to . . . . . ft., Dia . . . . . in. to . . . . . ft.  
 Casing height above land surface . . . . . 12 in., weight . . . . . 2.8 . . . . . lbs./ft. Wall thickness or gauge No. . . . . Sch. 40

TYPE OF SCREEN OR PERFORATION MATERIAL: 7 PVC 10 Asbestos-cement  
 1 Steel 3 Stainless steel 5 Fiberglass 8 RMP (SR) 11 Other (specify) . . . . .  
 2 Brass 4 Galvanized steel 6 Concrete tile 9 ABS 12 None used (open hole)

SCREEN OR PERFORATION OPENINGS ARE: 5 Gauzed wrapped 8 Saw cut 11 None (open hole)  
 1 Continuous slot 3 Mill slot 6 Wire wrapped 9 Drilled holes  
 2 Louvered shutter 4 Key punched 7 Torch cut 10 Other (specify) . . . . .

SCREEN-PERFORATED INTERVALS: From . . . . . 275 . . . . . ft. to 335 . . . . . ft., From . . . . . ft. to . . . . . ft.  
 From . . . . . ft. to . . . . . ft., From . . . . . ft. to . . . . . ft.  
 GRAVEL PACK INTERVALS: From . . . . . 10 . . . . . ft. to 335 . . . . . ft., From . . . . . ft. to . . . . . ft.  
 From . . . . . ft. to . . . . . ft., From . . . . . ft. to . . . . . ft.

6 GROUT MATERIAL: 1 Neat cement 2 Cement grout 3 Bentonite 4 Other . . . . .  
 Grout intervals: From . . . . . 0 . . . . . ft. to 10 . . . . . ft., From . . . . . ft. to . . . . . ft., From . . . . . ft. to . . . . . ft.

What is the nearest source of possible contamination:  
 1 Septic tank 4 Lateral lines 7 Pit privy 10 Livestock pens 14 Abandoned water well  
 2 Sewer lines 5 Cess pool 8 Sewage lagoon 11 Fuel storage 15 Oil well/Gas well  
 3 Watertight sewer lines 6 Seepage pit 9 Feedyard 12 Fertilizer storage 16 Other (specify below)  
 13 Insecticide storage . . . . .  
 Direction from well? South How many feet? 60

FROM	TO	LITHOLOGIC LOG	FROM	TO	LITHOLOGIC LOG
0	20	Clay			
20	200	Shale			
200	335	Sand rock with shale streaks			

7 CONTRACTOR'S OR LANDOWNER'S CERTIFICATION: This water well was (1) constructed, (2) reconstructed, or (3) plugged under my jurisdiction and was completed on (mo/day/year) . 9/22/85 . . . . . and this record is true to the best of my knowledge and belief. Kansas Water Well Contractor's License No. . . . . 186 . . . . . This Water Well Record was completed on (mo/day/yr) . . . . . 10/31/85 . . . . . under the business name of Kelly's Water Well Service by (signature) [Signature]

INSTRUCTIONS: Use typewriter or ball point pen, PLEASE PRESS FIRMLY and PRINT clearly. Please fill in blanks, underline or circle the correct answers. Send top three copies to Kansas Department of Health and Environment, Division of Environment, Environmental Geology Section, Topeka, KS 66620. Send one to WATER WELL OWNER and retain one for your records.