


WATER WELL RECORD Form WWC-5 KSA 82a-1212

1 LOCATION OF WATER WELL: Fraction Section Number Township Number Range Number
 COUNTY: 042 HODGEMAN SE 1/4 SW 1/4 SW 1/4 23 T 23 S R 22 W

Distance and direction from nearest town or city street address of well if located within city?
 FROM HANSTON; APPX 5 3/4 MILES SOUTH

2 WATER WELL OWNER: WALT D. SALMANS
 RR#, St. Address, Box #: PO BOX 128 Board of Agriculture, Division of Water Resources
 City, State, ZIP code: HANSTON, KS 67849-0128 Application Number: 13203

3 LOCATE WELL'S LOCATION WITH AN "X" IN SECTION BOX:

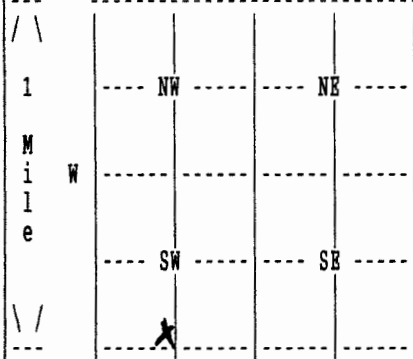

4 DEPTH OF COMPLETED WELL 107 ELEVATION: 0
 Depth(s) Groundwater Encountered 1. 0 ft. 2. 0 ft. 3. 0 ft.

WELL'S STATIC WATER LEVEL 31 ft. below land surface measured on mo/day/yr 06/13/06
 Pump test data: Well water was 88 ft. after 4 hours pumping 389 gpm

Estimated Yield 0 gpm: Well water was 0 ft. after 0 hours pumping 0 gpm

Bore Hole Diameter 24 in. to 107 ft., and in. to 0 ft.

WELL WATER TO BE USED AS: 02 IRRIGATION

Was a chemical/bacteriological sample submitted to department? No ;
 If yes, mo/day/yr sample was submitted Water well disinfected? Yes

5 TYPE OF BLANK CASING USED: 01 STEEL CASING JOINTS: WELDED
 Blank casing diameter 16 in. to 107 ft., Dia in. to 0 ft., Dia in. to 0 ft.
 Casing height above land surface 12 in., weight 42 lbs/ft. Wall thickness or gauge No. .250
 TYPE OF SCREEN OR PERFORATION MATERIAL: 01 STEEL
 SCREEN OR PERFORATION OPENINGS ARE: 01 CONT. SLOT

SCREEN PERFORATED INTERVALS: From 47 ft. to 87 ft., From 0 ft. to 0 ft.
 From 0 ft. to 0 ft., From 0 ft. to 0 ft.
 GRAVEL PACK INTERVALS: From 20 ft. to 107 ft., From 0 ft. to 0 ft.
 From 0 ft. to 0 ft., From 0 ft. to 0 ft.

6 GROUT MATERIAL 03 BENTONITE
 Grout Intervals: From 0 ft. to 20 ft., From 0 ft. to 0 ft., From 0 ft. to 0 ft.
 What is the nearest source of possible contamination: 14 ABAND. WELL
 Direction from well? SOUTHWEST How many feet? 29

FROM	TO	LITHOLOGIC LOG	FROM	TO	PLUGGING INTERVALS
0	2	02 SILT			
2	24	01 CLAY 05 SAND			
24	37	01 CLAY			
37	43	05 SAND			
43	65	05 SAND 11 GRAVEL 28 ROCK			
65	71	05 SAND 01 CLAY			
71	78	01 CLAY			
78	87	05 SAND 13 FINE GRAVEL			
87	90	31 CALICHE			
90	93	19 SHALE			

7 CONTRACTOR'S OR LANDOWNER'S CERTIFICATION: This water well was Constructed under my jurisdiction and was completed on (mo/day/year) 06/01/06 and this record is true to the best of my knowledge and belief. Kansas Water Well Contractor's License No. 145 This Water Well Record was completed on (mo/day/yr) 07/03/06 under the business name of HENKLE DRILLING & SUPPLY by (signature)

(Continued)

WATER WELL RECORD Form WWC-5 KSA 82a-1212

1 LOCATION OF WATER WELL: COUNTY: 042 HODGEMAN	Fraction SE 1/4 SW 1/4 SW 1/4	Section Number 23	Township Number T 23 S	Range Number R 22 W
---	----------------------------------	----------------------	---------------------------	------------------------

2 WATER WELL OWNER: WALT D. SALMANS
RR#, St. Address, Box # : PO BOX 128
City, State, ZIP code : HANSTON, KS 67849-0128
Board of Agriculture, Division of Water Resources
Application Number: 13203

FROM 93	TO 100	LITHOLOGIC LOG 31 CALICHE 20 LIMESTONE
------------	-----------	---

7 CONTRACTOR'S OR LANDOWNER'S CERTIFICATION: This water well was Constructed under my jurisdiction and was completed on (mo/day/year) 06/01/06 and this record is true to the best of my knowledge and belief. Kansas Water Well Contractor's License No. 145 This Water Well Record was completed on (mo/day/yr) 07/03/06 under the business name of HENKLE DRILLING & SUPPLY by (signature) *Bruce Henkle*