


WATER WELL RECORD Form WWC-5 KSA 82a-1212

1 LOCATION OF WATER WELL: Fraction Section Number Township Number Range Number  
 COUNTY: HODGEMAN SW 1/4 1/4 1/4 1 T 23 S R 22 W

Distance and direction from nearest town or city street address of well if located within city?  
 FROM HANSTON 3 SOUTH ON RD. 1 1/2 ON L ROAD

2 WATER WELL OWNER: HOUSMAN, MARY K.  
 RR#, St. Address. Box #: 304 S. LOGAN ST. Board of Agriculture, Division of Water Resources  
 City, State. ZIP code: HANSTON, KS 67849- Application Number:

3 LOCATE WELL'S LOCATION WITH AN "X" IN SECTION BOX: 4 DEPTH OF-COMPLETED WELL 205 ELEVATION: 0  
 Depth(s) Groundwater Encountered 1. 0 ft. 2. 0 ft. 3. 0 ft.

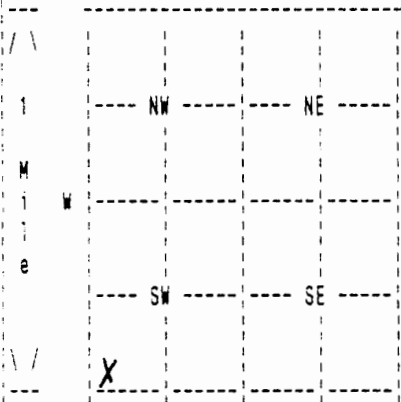

WELL'S STATIC WATER LEVEL 76 ft. below land surface measured on mo/day/yr 08/17/07  
 Pump testdata: Well water was 0 ft. after 0 hours pumping 0 gpm  
 Estimated Yield 45 gpm: Well water was 0 ft. after 0 hours pumping 0 gpm  
 Bore Hole Diameter 9 in. to 205 ft., and in. to 0 ft.  
 WELL WATER TO BE USED AS: DOMESTIC  
 Was a chemical/bacteriological sample submitted to department? No ;  
 If yes, mo/day/yr sample was submitted Water well disinfected? Yes

5 TYPE OF BLANK CASING USED: CERTA LOC CASIN CASING JOINTS: CERTA-LOC  
 Blank casing diameter 5 in. to 205 ft., Dia in. to 0 ft., Dia in. to 0 ft.  
 Casing height above land surface 12 in., weight 200 lbs/ft. Wall thickness or gauge No. 21  
 TYPE OF SCREEN OR PERFORATION MATERIAL: PVC  
 SCREEN OR PERFORATION OPENINGS ARE: SAW CUT

SCREEN PERFORATED INTERVALS: From 160 ft. to 200 ft., From 0 ft. to 0 ft.  
 From 0 ft. to 0 ft., From 0 ft. to 0 ft.  
 GRAVEL PACK INTERVALS: From 20 ft. to 205 ft., From 0 ft. to 0 ft.  
 From 0 ft. to 0 ft., From 0 ft. to 0 ft.

6 GROUT MATERIAL BENTONITE  
 Grout Intervals: From 0 ft. to 20 ft., From 0 ft. to 0 ft., From 0 ft. to 0 ft.  
 What is the nearest source of possible contamination: ABANDONED WELL  
 Direction from well? NORTHWEST How many feet? 20

FROM	TO	LITHOLOGIC LOG	FROM	TO	PLUGGING INTERVALS
0	20	01 TOPSOIL 05 CLAY 36 BLUE CLAY			
20	60	36 BLUE CLAY BLACK 05 CLAY			
60	140	16 GRAY CLAY 24 THINROCLAYER			
140	200	29 SANDSTONE			
200	220	29 SANDSTONE 16 GRAY CLAY			
220	240	16 GRAY CLAY			
240	260	16 GRAY CLAY 29 SANDSTONE 19 LAYERS			

7 CONTRACTOR'S OR LANDOWNER'S CERTIFICATION: This water well was Constructed under my jurisdiction and was completed on (mo/day/year) 08/18/07 and this record is true to the best of my knowledge and belief. Kansas Water Well Contractor's License No. 179 This Water Well Record was completed on (mo/day/yr) 10/29/07 under the business name of JOE'S WELL SERVICE, INC. by (signature) *Julius Creek*