

WATER WELL RECORD Form MWC-5 KSA 82a-1212


DRL
8/11/10

1 LOCATION OF WATER WELL: Fraction Section Number Township Number Range Number
 COUNTY: HODGENAN SE 1/4 NE 1/4 SE 1/4 20 T 23 S R 22 W

Distance and direction from nearest town or city street address of well if located within city?
 FROM HANSTON - 7 SOUTH, 1 WEST, 1 NORTH & 1 WEST

2 WATER WELL OWNER: GLEASON, LYNN
 RR#, St. Address, Box #: 2702 BUFFALO Board of Agriculture, Division of Water Resources
 City, State, ZIP code: DODGE CITY, KS 67801- Application Number:

3 LOCATE WELL'S LOCATION WITH AN "X" IN SECTION BOX:

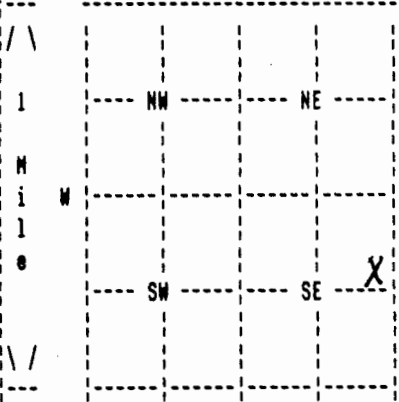

4 DEPTH OF COMPLETED WELL 165 ELEVATION: 0
 Depth(s) Groundwater Encountered 1. 0 ft. 2. 0 ft. 3. 0 ft.

WELL'S STATIC WATER LEVEL 0 ft. below land surface measured on mo/day/yr
 Pump test data: Well water was 0 ft. after 0 hours pumping 0 gpm

Estimated Yield 0 gpm: Well water was 0 ft. after 0 hours pumping 0 gpm

Bore Hole Diameter in. to 0 ft., and in. to 0 ft.

WELL WATER WAS: DOMESTIC

Was a chemical/bacteriological sample submitted to department? No ;
 If yes, mo/day/yr sample was submitted Water well disinfected? Yes

5 TYPE OF BLANK CASING USED:

CASING JOINTS:

Blank casing diameter 5 in. to 165 ft., Dia in. to 0 ft., Dia in. to 0 ft.
 Casing height above land surface 0 in., weight 0 lbs/ft. Wall thickness or gauge No.

TYPE OF SCREEN OR PERFORATION MATERIAL:

SCREEN OR PERFORATION OPENINGS ARE:

SCREEN PERFORATED INTERVALS: From 0 ft. to 0 ft., From 0 ft. to 0 ft.
 From 0 ft. to 0 ft., From 0 ft. to 0 ft.
 GRAVEL PACK INTERVALS: From 0 ft. to 0 ft., From 0 ft. to 0 ft.
 From 0 ft. to 0 ft., From 0 ft. to 0 ft.

6 GROUT MATERIAL BENTONITE

Grout Intervals: From 0 ft. to 0 ft., From 0 ft. to 0 ft., From 0 ft. to 0 ft.

What is the nearest source of possible contamination: NONE

Direction from well? How many feet? 0

FROM	TO	LITHOLOGIC LOG	FROM	TO	PLUGGING INTERVALS
			0	5	CLAY
			5	30	GROUT
			30	100	FILL SAND
			100	120	GROUT
			120	165	FILL SAND
			0	0	
			0	0	
			0	0	
			0	0	
			0	0	

7 CONTRACTOR'S OR LANDOWNER'S CERTIFICATION: This water well was Plugged under my jurisdiction and was completed on (mo/day/year) 06/12/10 and this record is true to the best of my knowledge and belief. Kansas Water Well Contractor's License No. 179 This Water Well Record was completed on (mo/day/yr) 06/14/10 under the business name of JOE'S WELL SERVICE, INC. by (signature) Judith Cook