


1 LOCATION OF WATER WELL: Fraction SE 1/4 SE 1/4 SE 1/4 Section Number 17 Township Number T 23 S Range Number R 22 E  
 County: Hedgesman

Distance and direction from nearest town or city street address of well if located within city?  
From Hanston, 5 miles south then 1 1/2 miles west.

2 WATER WELL OWNER: Clair Rufford  
 RR#, St. Address, Box #: 1017 Truman Board of Agriculture, Division of Water Resources  
 City, State, ZIP Code: Norton, KS, 67654 Application Number:

3 LOCATE WELL'S LOCATION WITH AN "X" IN SECTION BOX:

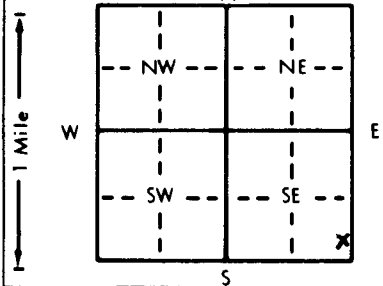

4 DEPTH OF COMPLETED WELL: 210' ft. ELEVATION:

Depth(s) Groundwater Encountered 1. .... ft. 2. .... ft. 3. .... ft.  
 WELL'S STATIC WATER LEVEL ... 119' ft. below land surface measured on mo/day/yr ... 12-19-94  
 Pump test data: Well water was .... ft. after .... hours pumping .... gpm  
 Est. Yield .... gpm; Well water was .... ft. after .... hours pumping .... gpm  
 Bore Hole Diameter: 9 7/8" in. to .... ft., and .... in. to .... ft.  
 WELL WATER TO BE USED AS:  
 1 Domestic  3 Feedlot  6 Oil field water supply  9 Dewatering  12 Other (Specify below)  
 2 Irrigation  4 Industrial  7 Lawn and garden only  10 Monitoring well  
 Was a chemical/bacteriological sample submitted to Department? Yes..... No ; If yes, mo/day/yr sample was sub-  
 mitted Water Well Disinfected? Yes  No

5 TYPE OF BLANK CASING USED:  
 1 Steel  3 RMP (SR)  5 Wrought iron  8 Concrete tile  CASING JOINTS: Glued  Clamped  
 2 PVC  4 ABS  7 Fiberglass  9 Other (specify below) Welded  
 Blank casing diameter 5" in. to 180' ft. Dia. .... in. to .... ft. Dia. .... in. to .... ft.  
 Casing height above land surface 18" in. weight .... lbs./ft. Wall thickness or gauge No. ....

TYPE OF SCREEN OR PERFORATION MATERIAL:  
 1 Steel  3 Stainless steel  5 Fiberglass  8 RMP (SR)  10 Asbestos-cement  
 2 Brass  4 Galvanized steel  6 Concrete tile  9 ABS  12 None used (open hole)  
 7 PVC  10 Asbestos-cement

SCREEN OR PERFORATION OPENINGS ARE:  
 1 Continuous slot  3 Mill slot  5 Gauzed wrapped  6 Saw cut  11 None (open hole)  
 2 Louvered shutter  4 Key punched  6 Wire wrapped  9 Drilled holes  
 7 Torch cut  10 Other (specify)

SCREEN-PERFORATED INTERVALS: From 180' ft. to 190' ft., From 200' ft. to 210' ft.  
 From .... ft. to .... ft., From .... ft. to .... ft.  
 GRAVEL PACK INTERVALS: From 20' ft. to 210' ft., From .... ft. to .... ft.  
 From .... ft. to .... ft., From .... ft. to .... ft.

6 GROUT MATERIAL: 1 Neat cement  2 Cement grout  3 Bentonite  4 Other   
 Grout Intervals: From 0 ft. to 20' ft., From .... ft. to .... ft.

What is the nearest source of possible contamination:  
 1 Septic tank  4 Lateral lines  7 Pit privy  10 Livestock pens  14 Abandoned water well  
 2 Sewer lines  5 Cess pool  8 Sewage lagoon  11 Fuel storage  15 Oil well/Gas well  
 3 Watertight sewer lines  6 Seepage pit  9 Feedyard  12 Fertilizer storage  16 Other (specify below)  
 13 Insecticide storage  Pasture well

Direction from well? How many feet?

FROM	TO	LITHOLOGIC LOG	FROM	TO	PLUGGING INTERVALS
0	1	Topsoil	176	185	Gray clay
1	8	Brown clay	185	190	Sandstone
8	10	Med. Sand	190	191	Iron Pyrite
10	18	white rock limestone layers	191	200	Gray clay
18	38	Blue green clay	200	206	Sandstone + Gray clay
38	40	Shale			
40	46	Blue green clay			
46	68	Bluish white clay			
68	120	Gray clay w/ rock ledges			
120	130	Gray clay			
130	136	Sandstone			
136	158	Gray + red clay mixed			
158	162	Sandstone			
162	175	Clay			
175	176	Iron pyrite			

7 CONTRACTOR'S OR LANDOWNER'S CERTIFICATION: This water well was  (1) constructed,  (2) reconstructed, or  (3) plugged under my jurisdiction and was completed on (mo/day/year) 12-20-94 and this record is true to the best of my knowledge and belief. Kansas Water Well Contractor's License No. 533 This Water Well Record was completed on (mo/day/yr) 12-20-94 under the business name of Janet Water Well Repair by (signature) [Signature]