


1 LOCATION OF WATER WELL: County: **Hodgeman** Fraction: **NE 1/4 NE 1/4 SE 1/4** Section Number: **5** Township Number: **T 23 S** Range Number: **R 23 E (W)**

Distance and direction from nearest town or city street address of well if located within city?  
**1 1/2 Miles East of Jetmore, Kansas**

2 WATER WELL OWNER: **Hodgeman County Commission** 01968019 MW-5  
 RR#, St. Address, Box #: **P.O. Box 7** Board of Agriculture, Division of Water Resources  
 City, State, ZIP Code: **Jetmore, Kansas 67854** Application Number:

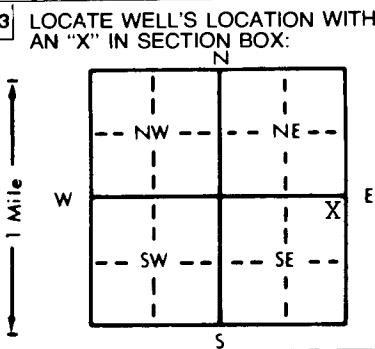

4 DEPTH OF COMPLETED WELL: **67** ft. ELEVATION: **Approx Surface 2271**  
 Depth(s) Groundwater Encountered 1. **58** ft. 2. ft. 3. ft.  
 WELL'S STATIC WATER LEVEL **61.49** ft. below land surface measured on mo/day/yr **10/03/96**  
 Pump test data: Well water was ft. after hours pumping gpm  
 Est. Yield gpm: Well water was ft. after hours pumping gpm  
 Bore Hole Diameter **7** in. to **6.7** ft., and in. to ft.  
 WELL WATER TO BE USED AS: 5 Public water supply 8 Air conditioning 11 Injection well  
 1 Domestic 3 Feedlot 6 Oil field water supply 9 Dewatering 12 Other (Specify below)  
 2 Irrigation 4 Industrial 7 Lawn and garden only **10** Monitoring well  
 Was a chemical/bacteriological sample submitted to Department? Yes No **X**; If yes, mo/day/yr sample was submitted  
 Water Well Disinfected? Yes No **X**

5 TYPE OF BLANK CASING USED: 5 Wrought iron 8 Concrete tile CASING JOINTS: Glued Clamped  
 1 Steel 3 RMP (SR) 6 Asbestos-Cement 9 Other (specify below) Welded  
**2** PVC 4 ABS 7 Fiberglass Threaded **X**  
 Blank casing diameter **2** in. to **52** ft., Dia. in. to ft., Dia. in. to ft.  
 Casing height above land surface **24** in., weight lbs./ft. Wall thickness or gauge No. **Schedule 40**  
 TYPE OF SCREEN OR PERFORATION MATERIAL: **7** PVC 10 Asbestos-cement  
 1 Steel 3 Stainless steel 5 Fiberglass 8 RMP (SR) 11 Other (specify)  
 2 Brass 4 Galvanized steel 6 Concrete tile 9 ABS 12 None used (open hole)  
 SCREEN OR PERFORATION OPENINGS ARE: 5 Gauzed wrapped 8 Saw cut 11 None (open hole)  
 1 Continuous slot **3** Mill slot 6 Wire wrapped 9 Drilled holes  
 2 Louvered shutter 4 Key punched 7 Torch cut 10 Other (specify)  
 SCREEN-PERFORATED INTERVALS: From **52** ft. to **67** ft., From ft. to ft.  
 From ft. to ft., From ft. to ft.  
 GRAVEL PACK INTERVALS: From **50** ft. to **67** ft., From ft. to ft.  
 From ft. to ft., From ft. to ft.

6 GROUT MATERIAL: **1** Neat cement 2 Cement grout **3** Bentonite 4 Other  
 Grout Intervals: From **0** ft. to **48** ft., From **48** ft. to **50** ft., From ft. to ft.  
 What is the nearest source of possible contamination: 10 Livestock pens 14 Abandoned water well  
 1 Septic tank 4 Lateral lines 7 Pit privy 11 Fuel storage 15 Oil well/Gas well  
 2 Sewer lines 5 Cess pool 8 Sewage lagoon 12 Fertilizer storage 16 Other (specify below)  
 3 Watertight sewer lines 6 Seepage pit 9 Feedyard 13 Insecticide storage **Landfill**  
 Direction from well? How many feet?

FROM	TO	LITHOLOGIC LOG	FROM	TO	PLUGGING INTERVALS
0.00	4.00	Silty Fine Sand			
4.00	26.00	Silty Lean Clay, Brown			
26.00	28.00	Fine to Coarse Sand & Gravel			
28.00	43.00	Silty Lean Clay With Fine to Medium Sand			
43.00	45.00	Silty Lean Clay With Fine to Coarse Sand			
45.00	67.00	Fine to Medium Sandy Clay With Trace Gravel			

7 CONTRACTOR'S OR LANDOWNER'S CERTIFICATION: This water well was **1** constructed, (2) reconstructed, or (3) plugged under my jurisdiction and was completed on (mo/day/year) **10/01/96** and this record is true to the best of my knowledge and belief. Kansas Water Well Contractor's License No. **416** This Water Well Record was completed on (mo/day/yr) **10/29/96** under the business name of **Terracon Consultants, Inc.** by (signature) *Steve Fischer*

INSTRUCTIONS: Use typewriter or ball point pen. PLEASE PRESS FIRMLY and PRINT clearly. Please fill in blanks, underline or circle the correct answers. Send top three copies to Kansas Department of Health and Environment, Bureau of Water, Topeka, Kansas 66620-0001. Telephone: 913-296-5545. Send one to WATER WELL OWNER and retain one for your records.