

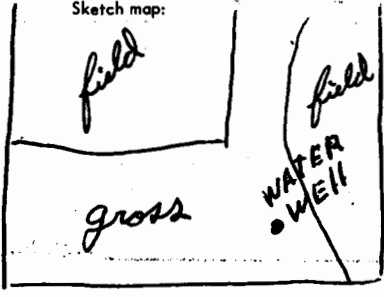
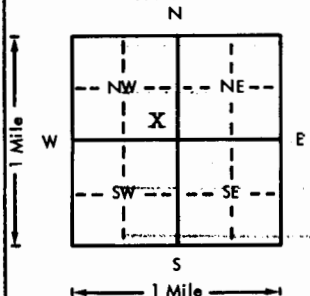
JETMORE
SE

USE TYPEWRITER OR BALL
POINT PEN-PRESS FIRMLY,
PRINT CLEARLY.

WATER WELL RECORD
KSA 82a-1201-1215

Kansas Department of Health and
Environment-Division of Environment
(Water well Contractors)
Topeka, Kansas 66620

BDD

1. Location of well:		County Hodgeman	Fraction SE 1/4 SE 1/4 NW 1/4	Section number I	Township number T 23 S R 23 E/W	Range number	
2. Distance and direction from nearest town or city: 5 E, 1/2 S Street address of well location if in city: of Jetmore.			3. Owner of well: Ray Smith R.R. or street: City, state, zip code: Jetmore, Kansas 67854				
4. Locate with "X" in section below:		Sketch map: 			6. Bore hole dia. 8 in. Completion date 4-1-77 Well depth 28 ft.		
					7. Cable tool <input checked="" type="checkbox"/> Rotary <input type="checkbox"/> Driven <input type="checkbox"/> Dug <input type="checkbox"/> Hollow rod <input type="checkbox"/> Jetted <input type="checkbox"/> Bored <input type="checkbox"/> Reverse rotary		
5. Type and color of material					8. Use: <input type="checkbox"/> Domestic <input type="checkbox"/> Public supply <input type="checkbox"/> Industry <input type="checkbox"/> Irrigation <input type="checkbox"/> Air conditioning <input checked="" type="checkbox"/> Stock <input type="checkbox"/> Lawn <input type="checkbox"/> Oil field water <input type="checkbox"/> Other		
					9. Casing: Material: <u>PITS</u> Height: <u>above</u> or below Threaded <input type="checkbox"/> Welded <input checked="" type="checkbox"/> <u>gl</u> Surface <u>18</u> in. RMP <input checked="" type="checkbox"/> PVC <input type="checkbox"/> Weight <u> </u> lbs./ft. Dia. <u>5</u> in. to <u>25</u> ft. depth Wall Thickness: inches or Dia. <u> </u> in. to <u> </u> ft. depth Gage No. <u>250</u>		
					10. Screen: Manufacturer's name <u>Sunflower</u> <u>Plastice Pipe Inc.</u> Type <u>RMP</u> Dia. <u>5in</u> <u>Slo</u> gauze <u>(1/16)</u> Length <u>14</u> Set between <u>24</u> ft. and <u>38</u> ft. Gravel pack? <u>Yes</u> Size range of material <u>1/8</u> to <u>1/4</u>		
					11. Static water level: <u>31</u> ft. below land surface Date <u>3-23-77</u> mo./day/yr.		
					12. Pumping level below land surfaces: <u>34</u> ft. after <u>1</u> hrs. pumping <u>5</u> g.p.m. <u> </u> ft. after <u> </u> hrs. pumping <u> </u> g.p.m. Estimated maximum yield <u>10</u> g.p.m.		
					13. Water sample submitted: <u> </u> mo./day/yr. Yes <input checked="" type="checkbox"/> No <input type="checkbox"/> Date <u> </u>		
					14. Well head completion: <u> </u> Pitless adapter <u>18</u> Inches above grade		
					15. Well grouted? <u>yes</u> With: <u> </u> Neat cement <u> </u> Bentonite <input checked="" type="checkbox"/> Concrete Depth: From <u>0</u> ft. to <u>15</u> ft.		
					16. Nearest source of possible contamination: ft. <u>20</u> Direction <u>SW</u> Type <u>Old well</u> Well disinfected upon completion? <input checked="" type="checkbox"/> Yes <input type="checkbox"/> No		
					17. Pump: Not installed Manufacturer's name <u>Aermotor Windmill</u> Model number <u> </u> HP <u> </u> Volts <u> </u> Length of drop pipe <u>35</u> ft. capacity <u>5</u> g.p.m. Type: <input type="checkbox"/> Submersible <input type="checkbox"/> Turbine <input type="checkbox"/> Jet <input type="checkbox"/> Reciprocating <input type="checkbox"/> Centrifugal <input checked="" type="checkbox"/> Other		
		(Use a second sheet if needed)					
18. Elevation:		19. Remarks: Concrete slab was installed <u>2211</u> <u>38</u> <u>2173</u> <u>TOPD</u>				20. Water well contractor's certification: This well was drilled under my jurisdiction and this report is true to the best of my knowledge and belief. <u>Knoefler Bros. Drilling</u> Business name <u>Jetmore, Kansas 130</u> License No. Address <u>Dale Knoefler</u> Signed <u>Dale Knoefler</u> Date <u>4-18-77</u> Authorized representative	

Forward the white, blue and pink copies to the Department of Health and Environment

Form WWC-5