

CORRECTION TO WATER WELL RECORD (WWC-5)

The following correction(s) was made to the attached WWC-5 log, in order to file the item or to rectify lacking or incorrect information.

Fraction (1/4 1/4 1/4) Section-Township-Range changed:

listed as 6-235-23W

changed to SW NW, 6-235-23W

Other changes: Initial statements: _____

Changed to: _____

Comments: "Roughan Street" is believed to be
Roughton Street

verification method: Written description, city map on internet, remarks on form,
and Jetmore 1:24,000 topo. map. initials: DRJ date: 7/26/2001

submitted by: Kansas Geological Survey, Data Resources Library, 1930 Constant Ave., Lawrence, KS 66047-3726
to: Kansas Dept of Health & Environment Bureau of Water Industrial Programs, Bldg 283, Forbes Field, KS 66620

USE TYPEWRITER OR BALL POINT PEN—PRESS FIRMLY, PRINT CLEARLY.

T R EW sec 1/4 1/4 1/4 No.


WATER WELL RECORD
KSA 82a-1201-1215

Kansas State Dept. Of Health
(Water Well Contractors)
Forbes-Bldg. 740
Topeka, Kansas 66620

1 Location of well:	County Hodgeman	Township name Haun Add,	Fraction	Section number 6	Town number 235	Range number 23W
---------------------	---------------------------	-----------------------------------	----------	----------------------------	---------------------------	----------------------------

Distance and direction from nearest town or city: **in Jetmore City**
Street address of well location if in city: **Roughan Street**

3 Owner of well: **W. M. Mock**
Address: **Jetmore, Kansas 67854**

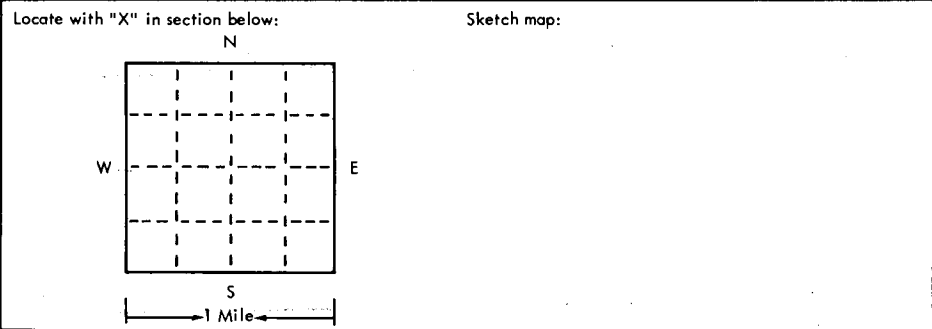

4 Well depth: **56** ft. Date of completion **5-7-75**
Well diameter **8** in.

5 Cable tool Rotary Driven Dug
 Hollow rod Jetted Bored Reverse rotary

6 Use: Domestic Public supply Industry
 Irrigation Air conditioning Commercial
 Test well

7 Casing: Material **RMP** Height: above/below **XXX**
Threaded Welded Surface **12** in.
Digm. Weight _____ lbs./ft. _____
5 in. to **56** ft. depth Drive shoe? Yes No
_____ in. to _____ ft. depth

2 Type and color of material	From	To
Top soil & clay	0	15
Fine to fine coarse sand	15	30
Coarse sand	30	45
Coarse sand & blue clay	45	60
Blue clay	60	70
Block 55'		
3/23' sat thick		
Location		
(use a second sheet if needed)		

8 Screen:
Manufacturer **Jess & Lowell**
Type **RMP** Dia. **5"**
 Slot gauge **1/8"** Length **20ft.**
Set between **35** ft. and **55** ft.
Fittings:
Gravel pack Yes No Size range of material **1/4"**

9 Static water level:
32 ft. below land surface Date **5-7-75**

10 Pumping level below land surfaces:
_____ ft. after _____ hrs. pumping _____ g.p.m.
_____ ft. after _____ hrs. pumping _____ g.p.m.
Estimated maximum yield _____ g.p.m.

11 Water sample submitted:
 Yes No Date _____

12 Well head completion: **None**
 Pitless adapter Inches above grade

13 Well grouted? Yes No
 Neat cement Bentonite _____
Depth: From **0** ft. to **10** ft.

14 Nearest source of possible contamination: **None that we know of.**
ft. _____ Direction _____ Type _____
Well disinfected upon completion? Yes No

15 Pump: **Windmill** Not installed
Manufacturer's name _____
Model number _____ HP _____ Volts _____
Length of drop pipe _____ ft. capacity _____ g.m.p.
Type:
 Submersible Turbine
 Jet Reciprocating
 Centrifugal Other

16 Remarks: elevation
Has excellent drainage to the Southwest.

Topography:
 Hill
 Slope
 Upland
 Valley

17 Water well contractor's certification:
This well was drilled under my jurisdiction and this report is true to the best of my knowledge and belief.

JOE'S WELL SERVICE **179**
Business name License No.
Address **Box 174 Cimarron, Ks.**
Signed **Ray Cich** Date **6-6-75**
Authorized representative