


WATER WELL RECORD Form WWC-5 KSA 82a-1212

1 LOCATION OF WATER WELL: Fraction Section Number Township Number Range Number
 COUNTY: 042 HODGEMAN NC NW 1/4 09 T 23 S R 23 W

Distance and direction from nearest town or city street address of well if located within city?
 FROM JETMORE; APPX 1 1/2 MILE EAST

2 WATER WELL OWNER: RODNEY & KAY OLIPHANT
 RR#, St. Address, Box #: RT 1 BOX 87 Board of Agriculture, Division of Water Resources
 City, State, ZIP code: OFFERLE, KS 67563-9721 Application Number: 13413

3 LOCATE WELL'S LOCATION WITH AN "X" IN SECTION BOX:

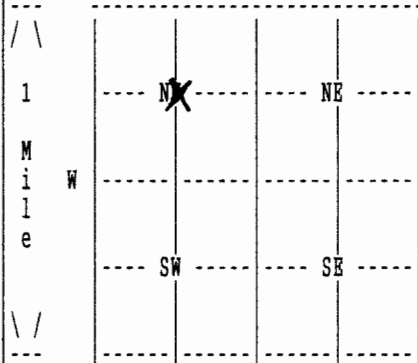

4 DEPTH OF COMPLETED WELL 293 ELEVATION: 0
 Depth(s) Groundwater Encountered 1. 0 ft. 2. 0 ft. 3. 0 ft.

WELL'S STATIC WATER LEVEL 69 ft. below land surface measured on mo/day/yr 10/26/04
 Pump test data: Well water was 191 ft. after 4 hours pumping 1200 gpm

Estimated Yield 0 gpm: Well water was 0 ft. after 0 hours pumping 0 gpm

Bore Hole Diameter 24 in. to 293 ft., and in. to 0 ft.

WELL WATER TO BE USED AS: 02 IRRIGATION

Was a chemical/bacteriological sample submitted to department? No ;
 If yes, mo/day/yr sample was submitted Water well disinfected? Yes

5 TYPE OF BLANK CASING USED: 01 STEEL CASING JOINTS: WELDED
 Blank casing diameter 16 in. to 293 ft., Dia in. to 0 ft., Dia in. to 0 ft.
 Casing height above land surface 12 in., weight 37 lbs/ft. Wall thickness or gauge No. .219
 TYPE OF SCREEN OR PERFORATION MATERIAL: 01 STEEL
 SCREEN OR PERFORATION OPENINGS ARE: 01 CONT. SLOT

SCREEN PERFORATED INTERVALS: From 168 ft. to 288 ft., From 0 ft. to 0 ft.
 From 0 ft. to 0 ft., From 0 ft. to 0 ft.
 GRAVEL PACK INTERVALS: From 20 ft. to 293 ft., From 0 ft. to 0 ft.
 From 0 ft. to 0 ft., From 0 ft. to 0 ft.

6 GROUT MATERIAL 03 BENTONITE
 Grout Intervals: From 0 ft. to 20 ft., From 0 ft. to 0 ft., From 0 ft. to 0 ft.
 What is the nearest source of possible contamination: 14 ABAND. WELL
 Direction from well? WEST How many feet? 97

FROM	TO	LITHOLOGIC LOG	FROM	TO	PLUGGING INTERVALS
0	1	02 SILT			
1	20	01 CLAY 31 CALICHE			
20	28	05 SAND 11 GRAVEL 28 ROCK			
28	31	19 SHALE			
31	70	19 SHALE 20 LIMESTONE 31 CALICHE			
70	76	31 CALICHE 23 SANDSTONE			
76	85	19 SHALE			
85	100	19 SHALE 31 CALICHE			
100	108	31 CALICHE 19 SHALE			
108	114	19 SHALE			

7 CONTRACTOR'S OR LANDOWNER'S CERTIFICATION: This water well was Constructed under my jurisdiction and was completed on (mo/day/year) 10/21/04 and this record is true to the best of my knowledge and belief. Kansas Water Well Contractor's License No. 145 This Water Well Record was completed on (mo/day/yr) 04/12/05 under the business name of HENKLE DRILLING & SUPPLY by (signature)

(Continued)

WATER WELL RECORD Form WWC-5 KSA 82a-1212

1 LOCATION OF WATER WELL: Fraction Section Number Township Number Range Number
COUNTY: 042 HODGEMAN 1/4 NC 1/4 NW 1/4 09 T 23 S R 23 W

2 WATER WELL OWNER: RODNEY & KAY OLIPHANT
RR#, St. Address, Box # : RT 1 BOX 87 Board of Agriculture, Division of Water Resources
City, State, ZIP code : OFFERLE, KS 67563-9721 Application Number: 13413

FROM	TO	LITHOLOGIC LOG
114	164	19 SHALE
164	188	23 SANDSTONE
188	204	23 SANDSTONE 31 CALICHE
204	233	23 SANDSTONE 19 SHALE
233	243	23 SANDSTONE 31 CALICHE
243	265	19 SHALE 31 CALICHE 23 SANDSTONE
265	273	19 SHALE 31 CALICHE 20 LIMESTONE
273	288	31 CALICHE 20 LIMESTONE 19 SHALE
288	300	19 SHALE 20 LIMESTONE

7 CONTRACTOR'S OR LANDOWNER'S CERTIFICATION: This water well was Constructed under my jurisdiction and was completed on (mo/day/year) 10/21/04 and this record is true to the best of my knowledge and belief. Kansas Water Well Contractor's License No. 145 This Water Well Record was completed on (mo/day/yr) 04/12/05 under the business name of HENKLE DRILLING & SUPPLY by (signature) *Bruce J. Oliphant*